

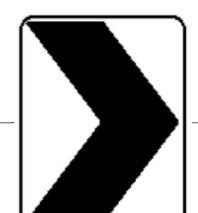
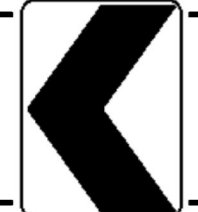



DIRECTION	MILEPOINT	LOCATION CODE (SHEET 4)	SIGN CODE	WIDTH (IN)	HEIGHT (IN)	SHEETING REMARKS	SIGN LEGEND	NEW SIGNS		EXISTING SIGNS			EXIST POST		NUMBER OF NEW POSTS	SQUARE STEEL (IN)			TUBULAR STEEL Ø (IN)				SIGN FRAME REQUIRED	REMARKS	SIGN DETAIL LOCATION				
								"A"	"B"	RETAIN	SALVAGE FROM	SALVAGE TO	REMOVE	RETAIN		REMOVE	1.75	2.00	2.50	FOUNDATION	3.00	3.50			4.00	5.00	SHSM	SIGN DETAILS SHEET #	STANDARD SHEET #
																	(LB / FT)				(LB / FT)								
EB WALLINGFORD VT RTE 140							FY-FLUORESCENT YELLOW FYG-FLUORESCENT YELLOW GREEN															"SHSM"-STANDARD HIGHWAY SIGNS AND MARKINGS BOOK							
		A	VW-258P	24	18	FYG		3.00															INSTALL ON RETAINED POST		5				
EB	3.535	A	R2-1				SPEED LIMIT 40					1																	
EB	3.610	A	W1-3R				RIGHT REVERSE TURN					1																	
		A	W13-1P				30 M.P.H.					1																	
		A	VD-700				11/4/17 MILE MARKER 1400 / 1125 / 0360				1	1	1		1	8'-0" X							REMOVE AND SALVAGE MILE MARKER ON TO NEW POST AT THE SAME STATION						
EB	3.710	A	W1-2L				LEFT TURN					1																	
		A	W13-1P				30 MPH PLAQUE					1																	
EB	3.750	A	W1-1L	30	30	FY	 11/4/17	6.25						1	12'-3" X								INSTALL ±210' UPSTATION FROM EXISTING CURVE WARNING AT MP 3.710 NB	X					
		A	W13-1P	18	18	FY		2.25																	X				
EB	3.760	B	W1-8R				 11/4/17					1																	
		B	W1-8R	18	24	FY		3.00						1	12'-6" X									X					
EB	3.775	A	W1-8L	18	24	FY	 11/7/17	3.00						1	13'-3" X								INSTALL 80' UPSTATION FROM EXISTING RIGHT CHEVRON AT MP 3.760	X					
EB	3.776	B	W1-8R	18	24	FY	 11/7/17	3.00						1	13'-9" X								INSTALL 80' UPSTATION FROM EXISTING RIGHT CHEVRON AT MP 3.760 EB	X					
EB	3.785	A	W1-8L				CHEVRON					1																	
EB	3.785	B	W1-8R				CHEVRON					1																	
SIGN SUMMARY SHEET							SHEET TOTALS	20.50	0.00	0	1	1	9	0	0	5	70.0	0	0.0	0.0	0.0	0.0	PROJECT NAME: STATEWIDE-SOUTH REGION PROJECT NUMBER: STPG SIGN(57)						
VERMONT AGENCY OF TRANSPORTATION							TOWN DIRECTIONAL TOTALS	489.4	0.0	46	4	4	100	0	0	86	1250.0	0		0.0			FILE NAME: z16t041Wallinaford140EB.xls PROJECT MANAGER: D. MUNRO DESIGNED BY: P. MCKECHNIE WALLINGFORD VT-140 EB 9	PLOT DATE: 2/27/2017 DRAWN BY: W. GORDON CHECKED: BRZEZOWSK SHEET 205 OF 264					