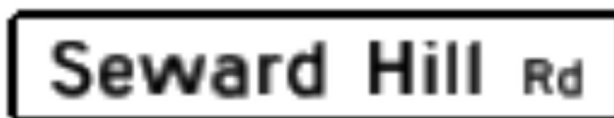
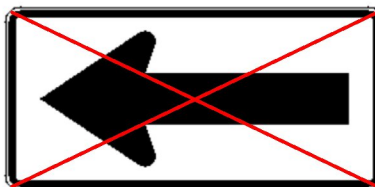


DIRECTION	MILEPOINT	LOCATION CODE (SHEET 4)	SIGN CODE	WIDTH (IN)	HEIGHT (IN)	SHEETING REMARKS	SIGN LEGEND	NEW SIGNS		EXISTING SIGNS				EXIST POST		NUMBER OF NEW POSTS	SQUARE STEEL (IN)			TUBULAR STEEL Ø (IN)				SIGN FRAME REQUIRED	REMARKS	SIGN DETAIL LOCATION					
								"A"	"B"	RETAIN	SALVAGE FROM	SALVAGE TO	REMOVE	RETAIN	REMOVE		1.75	2.00	2.50	FOUNDATION	3.00	3.50	4.00			5.00	SHSM	SIGN DETAILS SHEET #	STANDARD SHEET #		
																	(LB / FT)				(LB / FT)										
																	1.88	2.42	3.35		7.60	9.00	10.80			14.60					
EB WALLINGFORD VT RTE 140							FY-FLUORESCENT YELLOW FYG-FLUORESCENT YELLOW GREEN															"SHSM"-STANDARD HIGHWAY SIGNS AND MARKINGS BOOK									
EB	6.019	A	W1-1MdL	36	36		 11/2/17	9.00							2		13'-9" 12'-6" X							INSTALL ASSEMBLY 100' UPSTATION FROM SIGN AT MP 6.000 EB			2				
		A	W16-8aP	36	8			2.00																		5					
		A	W13-1P	24	24		 11/21/17	4.00																INSTALL ON LEFT POST	X						
EB	6.043	B	D3-1	60	12		 11/2/17  11/1/17	5.00							2		10'-6" 10'-0" X							INSTALL SIGN ±10' UPSTATION FROM EXISTING ARROW SIGN AT MP 6.045 EB			9				
EB	6.045	B	W1-6										1		X																
		B	W1-6	48	24		  11/1/17	8.00							2		12'-0" 11'-9" X								X						
EB	6.045	CD					SUGAR HILL RD						1		X																
		AB					SEWARDS HILL						1											SEWARD HILL RD (TH-84)							
EB	6.046	C	VR-017	24	30		 11/1/17 	5.00							1		12'-0" X							SEWARD HILL RD (TH-84) INSTALL SIGN ON NORTH SIDE OF TOWN HIGHWAY			T-70				
EB	6.048	C	R1-1	~~30~~	~~30~~			~~6.25~~		1				X		1	X							SEWARD HILL RD (TH-84) INSTALL ON SOUTH SIDE OF SEWARD HILL RD. LINE UP SIGN WITH UTILITY POLE ON SOUTH SIDE OF ROAD.	X	EXISTING SIGN IS IN LI NEW CONDITION AND PROPERLY PLACED; WAS RETAINED					
EB	6.050	C	VR-017				 11/1/17 LLL 24,000 LBS						1		X									SUGAR HILL RD (TH-6)							
		C	VR-017	24	30			5.00							1		10'-6" X									T-70					
EB	6.051	AB	D3-1	56	12		 11/2/17	4.67							2		8'-3" 8'-0" X							INSTALL ON LEGAL LOAD SIGN SIDE OF INTERSECTION			9				
EB	6.053	D	R1-1				STOP			1				X																	
		C	VD-700				MILE MARKER 1400/1125/0605			1																					
SIGN SUMMARY SHEET							SHEET TOTALS	48.92	0.00	2	0	0	4	0	0	11		165.0		0	0.0	0.0	0.0	0.0	PROJECT NAME: STATEWIDE-SOUTH REGION	PROJECT NUMBER: STPG SIGN(57)					
								SF	SF	EA	EA	EA	EA	EA	EA	EA		FT		EA	LB	LB	LB	LB							
							VERMONT AGENCY OF TRANSPORTATION																					FILE NAME: z16t041Wallinaford140EB.xls	PLOT DATE: 2/27/2017		
TOWN DIRECTIONAL TOTALS																							DESIGNED BY: P. MCKECHNIE	CHECKED: BRZEZOWSKI							
							489.4	0.0	46	4	4	100	0	0	86		1250.0		0	0.0				WALLINGFORD VT-140 EB 13			SHEET 209 OF 264				