
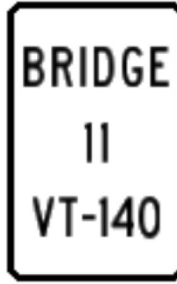


DIRECTION	MILEPOINT	LOCATION CODE (SHEET 4)	SIGN CODE	WIDTH (IN)	HEIGHT (IN)	SHEETING REMARKS	SIGN LEGEND	NEW SIGNS		EXISTING SIGNS			EXIST POST		NUMBER OF NEW POSTS	SQUARE STEEL (IN)			TUBULAR STEEL Ø (IN)				SIGN FRAME REQUIRED	REMARKS	SIGN DETAIL LOCATION				
								"A"	"B"	RETAIN	SALVAGE FROM	SALVAGE TO	REMOVE	RETAIN		REMOVE	1.75	2.00	2.50	FOUNDATION	3.00	3.50			4.00	5.00	SHSM	SIGN DETAILS SHEET #	STANDARD SHEET #
																	(LB / FT)				(LB / FT)								
EB WALLINGFORD VT RTE 140							FY-FLUORESCENT YELLOW FYG-FLUORESCENT YELLOW GREEN															"SHSM"-STANDARD HIGHWAY SIGNS AND MARKINGS BOOK							
EB	6.211	A	VD-701				 11/2/17																						
		A	VD-701	6	10			0.42							1											T-42			
EB	6.246	A	M3-2																										
		A	VM5-1																										
		A	M6-3																										
		A	M4-5																										
		A	VM5-1																										
		A	M6-3																										
		A	M3-3																										
		A	VM5-1																										
		A	M6-1R																										
EB	6.272	A	M3-2																										
		A	VM5-1																										
EB	6.280	A	VD-701				 11/2/17																						
		A	VD-701	6	10			0.42							1											T-42			
SIGN SUMMARY SHEET							SHEET TOTALS	0.83	0.00	11	0	0	2	0	0	2		20.0	0	0.0	0.0	0.0	0.0	PROJECT NAME: STATEWIDE-SOUTH REGION					
							SF	SF	EA	EA	EA	EA	EA	EA	EA		FT	EA	LB	LB	LB	LB	PROJECT NUMBER: STPG SIGN(57)						
VERMONT AGENCY OF TRANSPORTATION							TOWN DIRECTIONAL TOTALS	489.4	0.0	46	4	4	100	0	0	86		1250.0	0		0.0			FILE NAME: z16t041Wallinaford140EB.xls	PLOT DATE: 2/27/2017				
																							PROJECT MANAGER: D. MUNRO	DRAWN BY: W. GORDON					
																							DESIGNED BY: P. MCKECHNIE	CHECKED: BRZEZOWSK					
																							WALLINGFORD VT-140 EB 17	SHEET 213 OF 264					