

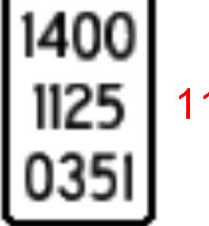
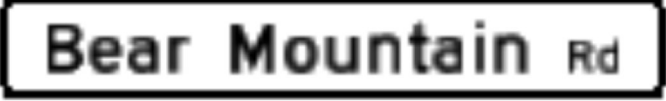





DIRECTION	MILEPOINT	LOCATION CODE (SHEET 4)	SIGN CODE	WIDTH (IN)	HEIGHT (IN)	SHEETING REMARKS	SIGN LEGEND	NEW SIGNS		EXISTING SIGNS			EXIST POST		NUMBER OF NEW POSTS	SQUARE STEEL (IN)			TUBULAR STEEL Ø (IN)				SIGN FRAME REQUIRED	REMARKS	SIGN DETAIL LOCATION				
								"A"	"B"	RETAIN	SALVAGE FROM	SALVAGE TO	REMOVE	RETAIN		REMOVE	1.75	2.00	2.50	FOUNDATION	3.00	3.50			4.00	5.00	SHSM	SIGN DETAILS SHEET #	STANDARD SHEET #
																	(LB / FT)				(LB / FT)								
<b>WB WALLINGFORD VT RTE 140</b>							FY-FLUORESCENT YELLOW FYG-FLUORESCENT YELLOW GREEN															"SHSM"-STANDARD HIGHWAY SIGNS AND MARKINGS BOOK							
WB	3.498	G	VR-017				LLL 24,000 LBS																						
		G	W14-2				NO OUTLET				1																		
		G	VR-017	24	30		 11/4/17	5.00																	T-70				
WB	3.490	FE					BEAR MT RD																						
		H	R1-1				STOP																						
		G	VD-700				MILE MARKER 1400/1125/0351																						
		H	R1-1	30	30		 11/4/17	6.25																					
		G	VD-700	6	10		 11/7/17	0.42																	T-44				
WB	3.489	FE	D3-1	72	12		 11/9/17	6.00																9					
WB	3.480	F	R2-1				SPEED LIMIT 40																						
WB	3.440	E	W1-6	48	24	FY	 11/20/17	8.00																					
WB	3.429	F	W1-6				 11/6/17																						
		F	W1-6	48	24	FY		8.00																					
WB	3.175	F	R2-1				 11/4/17																						
		F	R2-1	24	30			5.00																					
<b>SIGN SUMMARY SHEET</b>							SHEET TOTALS	38.67	0.00	0	1	1	8	0	0	8	120.0	0	0.0	0.0	0.0	0.0	PROJECT NAME: STATEWIDE-SOUTH REGION PROJECT NUMBER: STPG SIGN(57)						
VERMONT AGENCY OF TRANSPORTATION							TOWN DIRECTIONAL TOTALS	572.0	0.0	35	2	2	128	0	0	93	1325.0	2		183.0			FILE NAME: z16t041Wallinaford140WB.xls PLOT DATE: 2/27/2017 PROJECT MANAGER: D. MUNRO DRAWN BY: W. GORDON DESIGNED BY: P. MCKECHNIE CHECKED: BRZEZOWSKA WALLINGFORD VT-140 WB 9 SHEET 223 OF 264						