



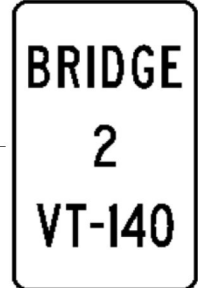

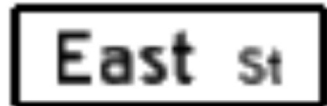


DIRECTION	MILEPOINT	LOCATION CODE (SHEET 4)	SIGN CODE	WIDTH (IN)	HEIGHT (IN)	SHEETING REMARKS	SIGN LEGEND	NEW SIGNS		EXISTING SIGNS				EXIST POST		NUMBER OF NEW POSTS	SQUARE STEEL (IN)			TUBULAR STEEL Ø (IN)				SIGN FRAME REQUIRED	REMARKS	SIGN DETAIL LOCATION			
								"A"	"B"	RETAIN	SALVAGE FROM	SALVAGE TO	REMOVE	RETAIN	REMOVE		1.75	2.00	2.50	FOUNDATION	3.00	3.50	4.00			5.00	SHSM	SIGN DETAILS SHEET #	STANDARD SHEET #
																	(LB / FT)				(LB / FT)								
WB WALLINGFORD VT RTE 140							FY-FLUORESCENT YELLOW FYG-FLUORESCENT YELLOW GREEN																"SHSM"-STANDARD HIGHWAY SIGNS AND MARKINGS BOOK						
		FE	D3-1	56	12		 11/8/17	4.67								2		11'-3" 11'-0" X									9		
WB	1.560	F	R2-1				 11/8/17																						
		F	R2-1	24	30				5.00								1		14'-3" X									X	
WB	1.480	F	W1-3L	30	30		 4/9/18	6.25																					
		F	W13-1P	18	18				2.25																			X	
WB	1.480-1.457	F					4/9/18 INSTALL (4) DELINEATOR POSTS																					T-40	
WB	1.440	F	W1-6L				LARGE ARROW LEFT																						
WB	1.315	F	VD-701				 11/9/17																						
		F	VD-701	6	10				0.42										8'-6" X									T-42	
WB	1.040	G	VR-017				 11/13/17																						
		G	VR-017	24	30			LLL 24,000 LBS	5.00																				T-70
WB	1.040	G	R2-1				SPEED LIMIT 25																						
WB	1.036	FE					 11/9/17																						
		FE	D3-1	32	12				2.67																			9	
WB	1.020	H	R1-1				STOP																						
SIGN SUMMARY SHEET							SHEET TOTALS	25.83	0.00	0	1	1	7	0	0	7	100.0	0	0.0	0.0	0.0	0.0	0.0	0.0	PROJECT NAME: STATEWIDE-SOUTH REGION PROJECT NUMBER: STPG SIGN(57)				
VERMONT AGENCY OF TRANSPORTATION							TOWN DIRECTIONAL TOTALS	572.0	0.0	35	2	2	128	0	0	93	1325.0	2						183.0	FILE NAME: z16t041Wallinaford140WB.xls PLOT DATE: 2/27/2017 PROJECT MANAGER: D. MUNRO DRAWN BY: W. GORDON DESIGNED BY: P. MCKECHNIE CHECKED: BRZEZOWSKA WALLINGFORD VT-140 WB 13 SHEET 227 OF 264				