



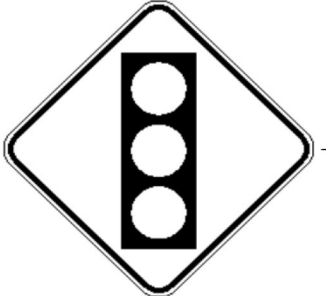


DIRECTION	MILEPOINT	LOCATION CODE (SHEET 4)	SIGN CODE	WIDTH (IN)	HEIGHT (IN)	SHEETING REMARKS	SIGN LEGEND	NEW SIGNS		EXISTING SIGNS				EXIST POST		NUMBER OF NEW POSTS	SQUARE STEEL (IN)			TUBULAR STEEL Ø (IN)				SIGN FRAME REQUIRED	REMARKS	SIGN DETAIL LOCATION			
								"A"	"B"	RETAIN	SALVAGE FROM	SALVAGE TO	REMOVE	RETAIN	REMOVE		1.75	2.00	2.50	FOUNDATION	3.00	3.50	4.00			5.00	SHSM	SIGN DETAILS SHEET #	STANDARD SHEET #
																	(LB / FT)				(LB / FT)								
<b>WB WALLINGFORD VT RTE 140</b>							FY-FLUORESCENT YELLOW FYG-FLUORESCENT YELLOW GREEN															"SHSM"-STANDARD HIGHWAY SIGNS AND MARKINGS BOOK							
		H	R1-1	30	30			6.25															INSTALL ON RETAINED POST	X					
		G	VD-700	6	10			0.42																INSTALL BACK TO BACK ON STOP SIGN POST			T-44		
WB	0.138	FE					PROSPECT ST																						
		GH					SCHOOL ST																						
		FE	D3-1	42	12			3.50																	9				
WB	0.130	F	W11-2																										
		F	W16-7p					11/8/17																					
		F	W11-2	30	30	FYG		11/9/17	6.25															X					
		F	W16-7p	24	12	FYG		2.00															X						
WB	0.128	G	R8-3	24	24			4.00																					
		G		24	10			4/9/18	1.67																4				
		G	M4-14	24	12				2.00															X					
WB	0.100	F	W3-3																										
		F	W3-3	30	30			11/9/17	6.25															X					
WB	0.084	G	VR-017				LLL 24,000 LBS																						
<b>SIGN SUMMARY SHEET</b>							<b>SHEET TOTALS</b>	32.33	0.00	0	0	0	6	0	0	4	60.0	0	0.0	0.0	0.0	0.0	PROJECT NAME: STATEWIDE-SOUTH REGION						
								SF	SF	EA	EA	EA	EA	EA	EA	EA	FT	EA	LB	LB	LB	LB	PROJECT NUMBER: STPG SIGN(57)						
																							FILE NAME: z16t041Wallinaford140WB.xls						
VERMONT AGENCY OF TRANSPORTATION							<b>TOWN DIRECTIONAL TOTALS</b>	572.0	0.0	35	2	2	128	0	0	93	1325.0	2		183.0			PLOT DATE: 2/27/2017						
																							DRAWN BY: W. GORDON						
																							CHECKED: BRZEZOWSK						
																							SHEET 231 OF 264						