


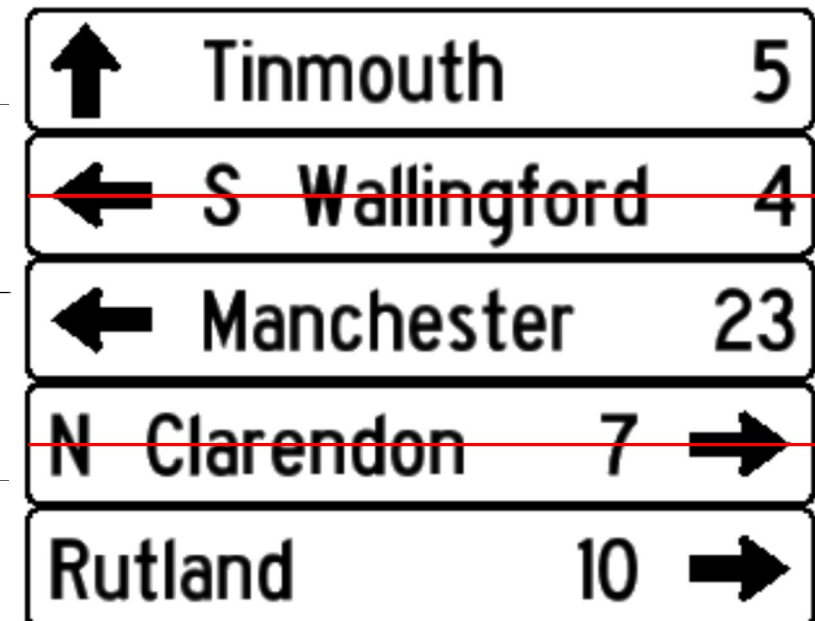


DIRECTION	MILEPOINT	LOCATION CODE (SHEET 4)	SIGN CODE	WIDTH (IN)	HEIGHT (IN)	SHEETING REMARKS	SIGN LEGEND	NEW SIGNS		EXISTING SIGNS			EXIST POST		NUMBER OF NEW POSTS	SQUARE STEEL (IN)			TUBULAR STEEL Ø (IN)				SIGN FRAME REQUIRED	REMARKS	SIGN DETAIL LOCATION				
								"A"	"B"	RETAIN	SALVAGE FROM	SALVAGE TO	REMOVE	RETAIN		REMOVE	1.75	2.00	2.50	FOUNDATION	3.00	3.50			4.00	5.00	SHSM	SIGN DETAILS SHEET #	STANDARD SHEET #
																	(LB / FT)				(LB / FT)								
WB WALLINGFORD VT RTE 140							FY-FLUORESCENT YELLOW FYG-FLUORESCENT YELLOW GREEN															"SHSM"-STANDARD HIGHWAY SIGNS AND MARKINGS BOOK							
		G	VR-017	24	30			11/9/17	5.00							1	9'-9" X									T-70			
WB	0.079	FE					TAFT TERRACE																						
		FE	D3-1	36	12			11/8/17	3.00							1	11'-0" X									9			
WB	0.079	H	R1-1					11/8/17																					
		G	VD-700																										
		H	R1-1	30	30																				X				
		G	VD-700	6	10																								
WB	0.070	F					(UP) TINMOUTH 5																						
		F					<-- S WALLINGFORD 4																						
		F					<--MANCHESTER 17																						
		F					N CLARENDON 7 -->																						
		F						4/9/18																					
		F	VD1-1A	53 72	10 12												13'-6" 13'-3" X								PROVIDE 7' CLEAR HEIGHT	T-93			
		F	VD1-1A	53 72	10 12																								
		F	VD1-1A	53 72	10 12																								
SIGN SUMMARY SHEET							SHEET TOTALS		32.67	0.00	0	0	0	8	0	0	4	30.0	2	183.0	0.0	0.0	0.0	PROJECT NAME: STATEWIDE-SOUTH REGION PROJECT NUMBER: STPG SIGN(57)					
VERMONT AGENCY OF TRANSPORTATION							SF	SF	EA	EA	EA	EA	EA	EA	EA	EA	EA	FT	EA	LB	LB	LB	LB	FILE NAME: z16t041Wallinaford140WB.xls PROJECT MANAGER: D. MUNRO DESIGNED BY: P. MCKECHNIE WALLINGFORD VT-140 WB 18	PLOT DATE: 2/27/2017 DRAWN BY: W. GORDON CHECKED: BRZEZOWSK SHEET 232 OF 264				
TOWN DIRECTIONAL TOTALS							572.0	0.0	35	2	2	128	0	0	93	1325.0	2	183.0											