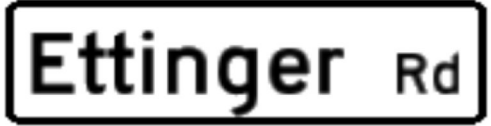
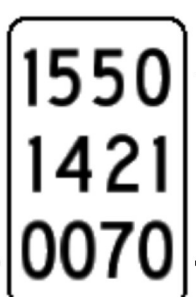
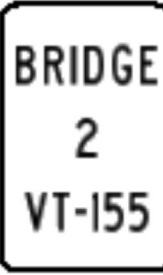


DIRECTION	MILEPOINT	LOCATION CODE (SHEET 4)	SIGN CODE	WIDTH (IN)	HEIGHT (IN)	SHEETING REMARKS	SIGN LEGEND	NEW SIGNS		EXISTING SIGNS				EXIST POST		NUMBER OF NEW POSTS	SQUARE STEEL (IN)			TUBULAR STEEL Ø (IN)				SIGN FRAME REQUIRED	REMARKS	SIGN DETAIL LOCATION					
								"A"	"B"	RETAIN	SALVAGE FROM	SALVAGE TO	REMOVE	RETAIN	REMOVE		1.75	2.00	2.50	FOUNDATION	3.00	3.50	4.00			5.00	SHSM	SIGN DETAILS SHEET #	STANDARD SHEET #		
																	(LB / FT)				(LB / FT)										
<b>NB WESTON VT ROUTE 155</b>							FY-FLUORESCENT YELLOW FYG-FLUORESCENT YELLOW GREEN																"SHSM"-STANDARD HIGHWAY SIGNS AND MARKINGS BOOK								
NB	0.040	A	M3-1				NORTH			1	1		X												SALVAGE SIGNS TO NEW POSTS AT SAME STATION						
		A	VM1-5				VERMONT 155			1	1																				
		A	M3-1				NORTH				1																				
		A	VM1-5				VERMONT 155				1																				
NB	0.075	A	VD2-1				E. WALLINGFORD 11			1			X																		
NB	0.115	A	R2-1				SPEED LIMIT 50			1			X																		
NB	0.705	C	VR-017				LLL 24,000 LBS				1																				
NB	0.711	AB	D3-1				ETTINGER RD					1	X																		
		D	R1-1				STOP			1																					
		C	VR-017				LLL 24,000 LBS				1	1																			
		C	VD-700				MILE MARKER 1550/1421/0070					1																			
		AB	D3-1	42	12		 10/31/17	3.50																							
		C	VD-700	6	10		 10/31/17	0.42																							
NB	0.925	A	VD-701				 10/31/17					1	X																		
		A	VD-701	6	10			0.42																							
<b>SIGN SUMMARY SHEET</b>							<b>SHEET TOTALS</b>	4.33	0.00	3	3	3	6	0	0	3		40.0	0	0.0	0.0	0.0	0.0								
								SF	SF	EA	EA	EA	EA	EA	EA	EA		FT	EA	LB	LB	LB	LB								
VERMONT AGENCY OF TRANSPORTATION							<b>TOWN DIRECTIONAL TOTALS</b>	12.8	0.0	3	3	3	8	0	0	4		55.0	0		0.0										
												PROJECT NAME: STATEWIDE-SOUTH REGION PROJECT NUMBER: STPG SIGN(57)										FILE NAME: z16t041WestonVT155 NB.xls PROJECT MANAGER: D. MUNRO DESIGNED BY: P. MCKECHNIE WESTON VT-155 NB 1					PLOT DATE: 2/27/2017 DRAWN BY: W. GORDON CHECKED: BRZEZOWSK SHEET 237 OF 264				