



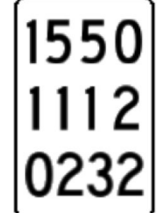



DIRECTION	MILEPOINT	LOCATION CODE (SHEET 4)	SIGN CODE	WIDTH (IN)	HEIGHT (IN)	SHEETING REMARKS	SIGN LEGEND	NEW SIGNS		EXISTING SIGNS			EXIST POST		NUMBER OF NEW POSTS	SQUARE STEEL (IN)			TUBULAR STEEL Ø (IN)				SIGN FRAME REQUIRED	REMARKS	SIGN DETAIL LOCATION				
								"A"	"B"	RETAIN	SALVAGE FROM	SALVAGE TO	REMOVE	RETAIN		REMOVE	1.75	2.00	2.50	FOUNDATION	3.00	3.50			4.00	5.00	SHSM	SIGN DETAILS SHEET #	STANDARD SHEET #
																	(LB / FT)				(LB / FT)								
NB MT HOLLY VT 155							FY-FLUORESCENT YELLOW FYG-FLUORESCENT YELLOW GREEN															"SHSM"-STANDARD HIGHWAY SIGNS AND MARKINGS BOOK							
		C	VD-700				MILE MARKER 1550/1112/0211				1											INSTALL BACK TO BACK ON STOP SIGN POST							
NB	2.133	AB	D3-1				HOWLAND FARM ROAD 24 56					1																	
		AB	D3-1	68	12		 11/3/17	5.67																	10				
NB	2.215	A	VD-701				 11/6/17					1																	
		A	VD-701	6	10			0.42																	T-42				
NB	2.335	AB					STRAIGHT RD TH23					1										STRAIGHT RD (TH-23)							
		C	VR-017				LLL 24,000 LBS					1																	
		C	VR-017	24	30		 11/2/17	5.00														INSTALL SIGN ON RETAINED POST AT SAME STATION			T-70				
NB	2.335	C					REDUCE SPEED AHEAD					1																	
NB	2.345	D	R1-1				MILE MARKER 1550/1112/0232					1																	
		C	VD-700				 11/2/17	6.25																	X				
		D	R1-1	30	30																								
		C	VD-700	6	10		 11/3/17	0.42														INSTALL BACK TO BACK ON STOP SIGN POST			T-44				
NB	2.345	AB	D3-1	64	12		 11/2/17	5.33														INSTALL INDEPENDENTLY ON TWO POSTS 10' FROM EDGE OF PAVEMENT. THINNING AND TRIMMING			10				
SIGN SUMMARY SHEET							SHEET TOTALS	23.08	0.00	0	0	1	7	0	0	6	55.0	0	0.0	0.0	0.0	0.0	PROJECT NAME: STATEWIDE-SOUTH REGION						
								SF	SF	EA	EA	EA	EA	EA	EA	EA	FT	EA	LB	LB	LB	LB	PROJECT NUMBER: STPG SIGN(57)						
VERMONT AGENCY OF TRANSPORTATION							TOWN DIRECTIONAL TOTALS	235.3	0.0	10	4	4	56	0	1	50	675.0	0		0.0			FILE NAME: z16t041Mt HollyVT155 NB.xls	PLOT DATE: 2/27/2017					
																						PROJECT MANAGER: D. MUNRO	DRAWN BY: W. GORDON						
																						DESIGNED BY: P. MCKECHNIE	CHECKED: BRZEZOWSK						
																						MOUNT HOLLY VT-155 NB 3	SHEET 244 OF 264						