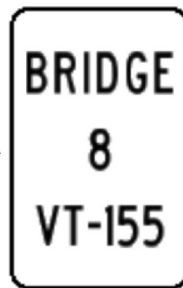
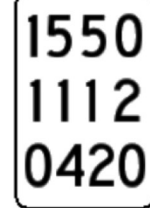


DIRECTION	MILEPOINT	LOCATION CODE (SHEET 4)	SIGN CODE	WIDTH (IN)	HEIGHT (IN)	SHEETING REMARKS	SIGN LEGEND	NEW SIGNS		EXISTING SIGNS				EXIST POST		NUMBER OF NEW POSTS	SQUARE STEEL (IN)			TUBULAR STEEL Ø (IN)				SIGN FRAME REQUIRED	REMARKS	SIGN DETAIL LOCATION			
								"A"	"B"	RETAIN	SALVAGE FROM	SALVAGE TO	REMOVE	RETAIN	REMOVE		1.75	2.00	2.50	FOUNDATION	3.00	3.50	4.00			5.00	SHSM	SIGN DETAILS SHEET #	STANDARD SHEET #
																	(LB / FT)				(LB / FT)								
																	1.88	2.42	3.35		7.60	9.00	10.80			14.60			
NB MT HOLLY VT 155							FY-FLUORESCENT YELLOW FYG-FLUORESCENT YELLOW GREEN															"SHSM"-STANDARD HIGHWAY SIGNS AND MARKINGS BOOK							
NB	3.715	A	VD-701				 11/7/17								X														
		A	VD-701	6	10			0.42								1	9'-0" X										T-42		
NB	4.115	A					REVERSE CURVE W/ INTERSECTION																						
		A	W13-1P				40 MPH PLAQUE																						
		A		36	36		 11/13/17	9.00									2	14'-0" 13'-6" X								2			
		A	W13-1P	24	24			4.00																INSTALL ON LEFT OF POST	X				
							 11/7/17																						
NB	4.171	A	S3-1	36	36	FYG		9.00																	X				
NB	4.205	A	VD1-1A																										
		A	VD-700																										
		A	S3-1				 SCHOOL BUS STOP AHEAD																						
		A	VD1-1A	72	12		 11/17/17	6.00									2	15'-3" 13'-0" X								T-93			
		A	VD-700	6	10			0.42																INSTALL ON LEFT POST			T-44		
NB	4.257	C	VR-017				 11/2/17																	TARBELLVILLE RD (TH-1)					
		C	VR-017	24	30			5.00								1	14'-0" X									T-70			
SIGN SUMMARY SHEET							SHEET TOTALS	33.83	0.00	0	0	0	7	0	0	6		85.0		0	0.0	0.0	0.0	0.0	PROJECT NAME: STATEWIDE-SOUTH REGION	PLOT DATE: 2/27/2017			
								SF	SF	EA	EA	EA	EA	EA	EA	EA		FT		EA	LB	LB	LB	LB	PROJECT NUMBER: STPG SIGN(57)	DRAWN BY: W. GORDON			
																									FILE NAME: z16t041Mt HolivVT155 NB.xls	CHECKED: BRZEZOWSKI			
							VERMONT AGENCY OF TRANSPORTATION																			DESIGNED BY: P. MCKECHNIE	SHEET 246 OF 264		
TOWN DIRECTIONAL TOTALS							235.3	0.0	10	4	4	56	0	1	50		675.0		0	0.0				MOUNT HOLLY VT-155 NB 5					