
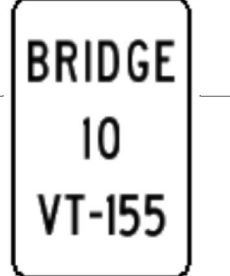
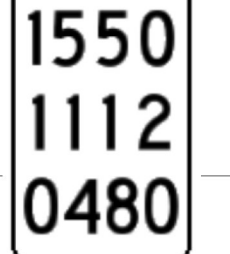
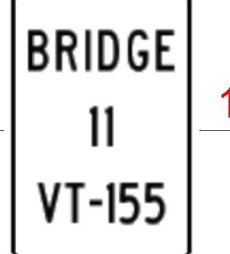





DIRECTION	MILEPOINT	LOCATION CODE (SHEET 4)	SIGN CODE	WIDTH (IN)	HEIGHT (IN)	SHEETING REMARKS	SIGN LEGEND	NEW SIGNS		EXISTING SIGNS			EXIST POST		NUMBER OF NEW POSTS	SQUARE STEEL (IN)			TUBULAR STEEL Ø (IN)				SIGN FRAME REQUIRED	REMARKS	SIGN DETAIL LOCATION				
								"A"	"B"	RETAIN	SALVAGE FROM	SALVAGE TO	REMOVE	RETAIN		REMOVE	1.75	2.00	2.50	FOUNDATION	3.00	3.50			4.00	5.00	SHSM	SIGN DETAILS SHEET #	STANDARD SHEET #
																	(LB / FT)				(LB / FT)								
NB MT HOLLY VT 155							FY-FLUORESCENT YELLOW FYG-FLUORESCENT YELLOW GREEN															"SHSM"-STANDARD HIGHWAY SIGNS AND MARKINGS BOOK							
		A	R2-1	24	30		 11/9/17	5.00							1	14'-9" X										X			
NB	4.805	A	VD-701				 11/8/17																						
		A	VD-700																										
		A	VD-701	6	10			 11/8/17	0.42																INSTALL SIGN ON RETAINED POST			T-42	
		A	VD-700	6	10				0.42																			T-44	
NB	4.995	A	VD-701				 11/8/17																						
		A	VD-701	6	10				0.42																INSTALL SIGN ON RETAINED POST			T-42	
NB	5.456	C	VR-017				 11/3/17																						
		C	VR-017	24	30				5.00						1	13'-3" X								BARLOW RD (TH-16) MOVE 25' CLOSER TO INTERSECTION			T-70		
NB	5.463	D	R1-1				 11/3/17																						
		C	VD-700					MILE MARKER 1550/1112/0546																					
		D	R1-1	30	30				6.25						1	13'-3" X										X			
		C	VD-700	6	10			0.42																INSTALL BACK TO BACK ON STOP SIGN POST			T-44		
NB	5.463	AB	D3-1				 11/3/17																						
		AB	D3-1	60	12				5.00						2	11'-6" 11'-0" X								INSTALL INDEPENDENTLY ON TWO POSTS, 8' FROM STOP SIGN BETWEEN STOP SIGN AND ROAD			10		
SIGN SUMMARY SHEET							SHEET TOTALS	22.92	0.00	0	0	0	7	0	0	5	75.0	0	0.0	0.0	0.0	0.0	PROJECT NAME: STATEWIDE-SOUTH REGION PROJECT NUMBER: STPG SIGN(57)						
								SF	SF	EA	EA	EA	EA	EA	EA	EA	FT	EA	LB	LB	LB	LB	FILE NAME: z16t041Mt HollivVT155 NB.xls PROJECT MANAGER: D. MUNRO	PLOT DATE: 2/27/2017 DRAWN BY: W. GORDON					
VERMONT AGENCY OF TRANSPORTATION							TOWN DIRECTIONAL TOTALS	235.3	0.0	10	4	4	56	0	1	50	675.0	0		0.0			DESIGNED BY: P. MCKECHNIE MOUNT HOLLY VT-155 NB 7	CHECKED: BRZEZOWSK SHEET 248 OF 264					