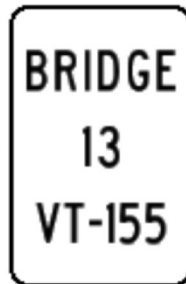
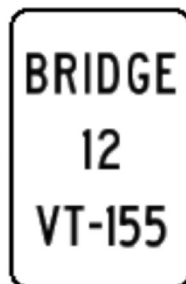


DIRECTION	MILEPOINT	LOCATION CODE (SHEET 4)	SIGN CODE	WIDTH (IN)	HEIGHT (IN)	SHEETING REMARKS	SIGN LEGEND	NEW SIGNS		EXISTING SIGNS				EXIST POST		NUMBER OF NEW POSTS	SQUARE STEEL (IN)			TUBULAR STEEL Ø (IN)				SIGN FRAME REQUIRED	REMARKS	SIGN DETAIL LOCATION			
								"A"	"B"	RETAIN	SALVAGE FROM	SALVAGE TO	REMOVE	RETAIN	REMOVE		1.75	2.00	2.50	FOUNDATION	3.00	3.50	4.00			5.00	SHSM	SIGN DETAILS SHEET #	STANDARD SHEET #
																	(LB / FT)				(LB / FT)								
																	1.88	2.42	3.35		7.60	9.00	10.80			14.60			
SB MT HOLLY VT 155							FY-FLUORESCENT YELLOW FYG-FLUORESCENT YELLOW GREEN															"SHSM"-STANDARD HIGHWAY SIGNS AND MARKINGS BOOK							
SB	7.415	F	R2-1				11/13/17 SPEED LIMIT 50 MPH					1					12'-6" X						INSTALL ACROSS FROM SB- FACING SPEED LIMIT 35 SIGN						
SB	7.395	F	R2-1				 SPEED LIMIT 50 MPH			1		1		X															
SB	7.390	F	W1-2L	30	30		 11/28/17	6.25								1		13'-6" X						INSTALL 25' DOWNSTATION FROM EXISTING SIGN AT MP 7.395	X				
SB	7.120	F	VD-701				 11/13/17					1		X															
		F	VD-701	6	10			0.42								1		8'-9" X									T-42		
SB	6.905	F					BUMP			1				X										SEASONAL SIGN					
SB	6.895	F	VD-701				 11/13/17					1		X															
		F	VD-701	6	10			0.42								1		7'-3" X									T-42		
SB	6.890	FE	D3-1				TH8 Fowler Brook Rd			1				X										FOWLER BROOK RD (TH-8)					
SB	6.885	G	VR-017				 11/3/17					1	X											THINNING AND TRIMMING INSTALL ON RETAINED POST				T-70	
		G	VR-017	24	30			5.00																					
SB	6.880	H	R1-1											X															
		G	VD-700				 MILE MARKER 1550/1112/0689				1																		
		H	R1-1	30	30		11/3/17	6.25								1		11'-3" X							X				
		G	VD-700				MILE MARKER 1550/1112/0689					1												INSTALL BACK TO BACK ON STOP SIGN POST					
SIGN SUMMARY SHEET							SHEET TOTALS	18.33	0.00	2	2	2	6	0	0	5		65.0		0	0.0	0.0	0.0	0.0	PROJECT NAME: STATEWIDE-SOUTH REGION				
								SF	SF	EA	EA	EA	EA	EA	EA	EA		FT		EA	LB	LB	LB	LB	PROJECT NUMBER: STPG SIGN(57)				
																										FILE NAME: z16t041Mt HollyVT155 SB.xls	PLOT DATE: 2/27/2017		
VERMONT AGENCY OF TRANSPORTATION							TOWN DIRECTIONAL TOTALS	171.1	0.0	7	3	3	39	0	0	32		465.0		0		0.0		PROJECT MANAGER: D. MUNRO					
																									DESIGNED BY: P. MCKECHNIE	DRAWN BY: W. GORDON			
																							CHECKED: BRZEZOWSKI	SHEET 251 OF 264					
																								MOUNT HOLLY VT-155 SB 1					