
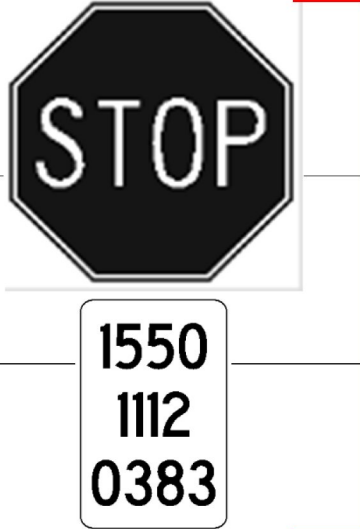
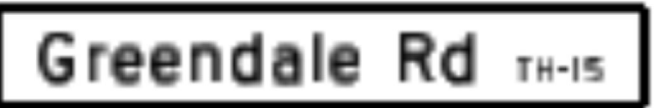
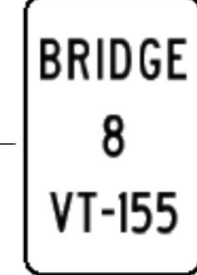
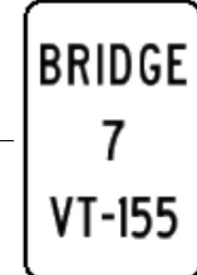


DIRECTION	MILEPOINT	LOCATION CODE (SHEET 4)	SIGN CODE	WIDTH (IN)	HEIGHT (IN)	SHEETING REMARKS	SIGN LEGEND	NEW SIGNS		EXISTING SIGNS			EXIST POST		NUMBER OF NEW POSTS	SQUARE STEEL (IN)			TUBULAR STEEL Ø (IN)				SIGN FRAME REQUIRED	REMARKS	SIGN DETAIL LOCATION				
								"A"	"B"	RETAIN	SALVAGE FROM	SALVAGE TO	REMOVE	RETAIN		REMOVE	1.75	2.00	2.50	FOUNDATION	3.00	3.50			4.00	5.00	SHSM	SIGN DETAILS SHEET #	STANDARD SHEET #
																	(LB / FT)				(LB / FT)								
SB MT HOLLY VT 155							FY-FLUORESCENT YELLOW FYG-FLUORESCENT YELLOW GREEN															"SHSM"-STANDARD HIGHWAY SIGNS AND MARKINGS BOOK							
SB	3.840	G	VR-017				LEGAL LOAD LIMIT 16,000 LBS					1	X									GREENDALE RD (TH-15)							
		G	VR-017	24	30		 11/3/17	5.00														INSTALL ON RETAINED POST			T-70				
SB	3.835	H	R1-1									1	X																
		G	VD-700				 11/3/17	6.25				1											X						
		H	R1-1	30	30																								
		G	VD-700	6	10			0.42														INSTALL BACK TO BACK ON STOP SIGN POST			T-44				
SB	3.835	FE	D3-1				 11/3/17					1		X															
		FE	D3-1	72	12			6.00						2		11'-0" 10'-3" X						INSTALL MINIMUM 5' AWAY FROM STOP SIGN		10					
SB	3.720	F	VD-701				 11/7/17					1	X																
		F	VD-701	6	10			0.42																	T-42				
SB	3.410	F	VD-701				 11/6/17					1	X																
		F	VD-701	6	10			0.42																	T-42				
SB	3.253	FE					SCAMPSVILLE ROAD 15					1		X															
		G	VR-017				LEGAL LOAD LIMIT 16,000 LBS					1		X															
SIGN SUMMARY SHEET							SHEET TOTALS	18.50	0.00	0	0	0	8	0	0	2	30.0	0	0.0	0.0	0.0	0.0	PROJECT NAME: STATEWIDE-SOUTH REGION PROJECT NUMBER: STPG SIGN(57)						
VERMONT AGENCY OF TRANSPORTATION							TOWN DIRECTIONAL TOTALS	171.1	0.0	7	3	3	39	0	0	32	465.0	0		0.0			FILE NAME: z16t041Mt HollyVT155 SB.xls PROJECT MANAGER: D. MUNRO DESIGNED BY: P. MCKECHNIE MOUNT HOLLY VT-155 SB 4	PLOT DATE: 2/27/2017 DRAWN BY: W. GORDON CHECKED: BRZEZOWSKA SHEET 254 OF 264					