




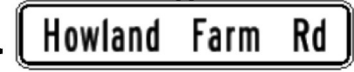


| DIRECTION | MILEPOINT | LOCATION CODE (SHEET 4) | SIGN CODE | WIDTH (IN) | HEIGHT (IN) | SHEETING REMARKS | SIGN LEGEND | NEW SIGNS | | EXISTING SIGNS | | | EXIST POST | | NUMBER OF NEW POSTS | SQUARE STEEL (IN) | | | TUBULAR STEEL Ø (IN) | | | | SIGN FRAME REQUIRED | REMARKS | SIGN DETAIL LOCATION | | | | | | |
|----------------------------------|-----------|-------------------------|-----------|------------|-------------|------------------|--|-----------|------|----------------|--------------|------------|------------|--------|---------------------|-------------------|-----------|------|----------------------|------------|-----------|---|---|-----------------------|----------------------|------|---|----------------------|------------------|------|------|
| | | | | | | | | "A" | "B" | RETAIN | SALVAGE FROM | SALVAGE TO | REMOVE | RETAIN | | REMOVE | 1.75 | 2.00 | 2.50 | FOUNDATION | 3.00 | 3.50 | | | 4.00 | 5.00 | SHSM | SIGN DETAILS SHEET # | STANDARD SHEET # | | |
| | | | | | | | | | | | | | | | | | (LB / FT) | | | | (LB / FT) | | | | | | | | | | |
| SB MT HOLLY VT 155 | | | | | | | FY-FLUORESCENT YELLOW FYG-FLUORESCENT YELLOW GREEN | | | | | | | | | | | | | | | "SHSM"-STANDARD HIGHWAY SIGNS AND MARKINGS BOOK | | | | | | | | | |
| SB | 3.248 | H | R1-1 | | | | STOP | | | | | | | | | | | | | | | | | | | | | | | | |
| | | G | VD-700 | | | | MILE MARKER 1550/1112/0324 | | | | 1 | | | | | | | | | | | | | | | | | | | | |
| | | FE | D3-1 | 68 | 12 | |  11/7/17 | 5.67 | | | | | | | | | | | | | | | 2 | 11'-3" 11'-0" X | | | INSTALL 10' FROM LLL BETWEEN LLL AND ROAD | | 10 | | |
| | | G | VD-700 | | | | MILE MARKER 1550/1112/0324 | | | | 1 | | | | | | | | | | | | | | | | INSTALL ON POST CLOSEST TO THE ROAD | | | | |
| SB | 2.709 | FE | D3-1 | | | | Dana Ln PVT | | | 1 | | | | | | | | | | | | | | | | | | | | | |
| SB | 2.580 | F | VW-000 | | | | MOOSE CROSSING | | | | | | | | | | | | | | | | | | | | | | | | |
| | | F | W7-3aP | | | | NEXT 5 MILES | | | | | | | | | | | | | | | | | | | | | | | | |
| | | F | VW-001 | 30 | 30 | |  11/7/17 | 6.25 | | | | | | | | | | | | | | | 1 | 17'-0" X | | | | | | | T-80 |
| | | F | | 24 | 18 | |  | 3.00 | | | | | | | | | | | | | | | | | | | | | | 4 | |
| SB | 2.245 | F | VW-054R | | | |  11/27/17 | | | | | | | | | | | | | | | | | | | | | | | | |
| | | F | VW-054R | 30 | 30 | | | 6.25 | | | | | | | | | | | | | | | 1 | 16'-3" X | | | | | | T-80 | |
| SB | 2.207 | F | W2-2 | 30 | 30 | |  11/3/17 | 6.25 | | | | | | | | | | | | | | | | | | | INSTALL 200' DOWNSTATION FROM EXISTING SIGN AT MP 2.245 | | | | |
| | | F | W16-8P | 39 | 8 | |  11/3/17 | 2.17 | | | | | | | | | | | | | | | | | | | | | | 5 | |
| SB | 0.920 | F | W7-1a | | | | HILL WARNING 7% | | | | | | | | | | | | | | | | | | | | | | | | |
| | | F | W7-3aP | | | | NEXT 1 MILE | | | | | | | | | | | | | | | | | | | | | | | | |
| SIGN SUMMARY SHEET | | | | | | | SHEET TOTALS | 29.58 | 0.00 | 1 | 1 | 1 | 7 | 0 | 0 | 5 | 75.0 | 0 | 0.0 | 0.0 | 0.0 | 0.0 | PROJECT NAME: STATEWIDE-SOUTH REGION PROJECT NUMBER: STPG SIGN(57) | | | | | | | | |
| VERMONT AGENCY OF TRANSPORTATION | | | | | | | TOWN DIRECTIONAL TOTALS | 171.1 | 0.0 | 7 | 3 | 3 | 39 | 0 | 0 | 32 | 465.0 | 0 | | | 0.0 | FILE NAME: z16t041Mt HollyVT155 SB.xls PROJECT MANAGER: D. MUNRO DESIGNED BY: P. MCKECHNIE MOUNT HOLLY VT-155 SB 5 | | | | | | | | | |
| | | | | | | | | | EA | EA | EA | EA | EA | EA | EA | FT | EA | LB | LB | LB | LB | PLOT DATE: 2/27/2017 DRAWN BY: W. GORDON CHECKED: BRZEZOWSKI SHEET 255 OF 264 | | | | | | | | | |