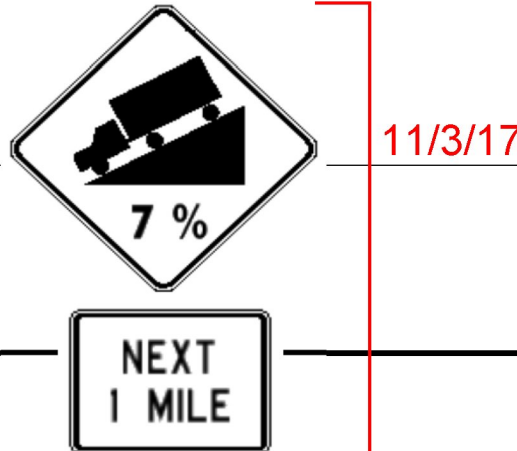
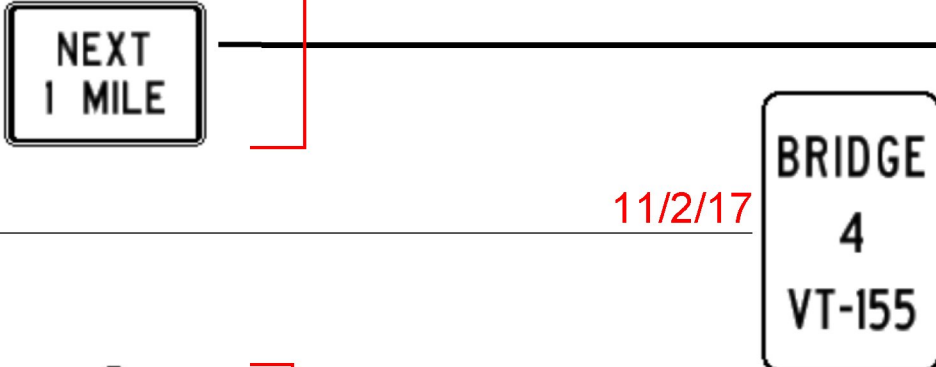
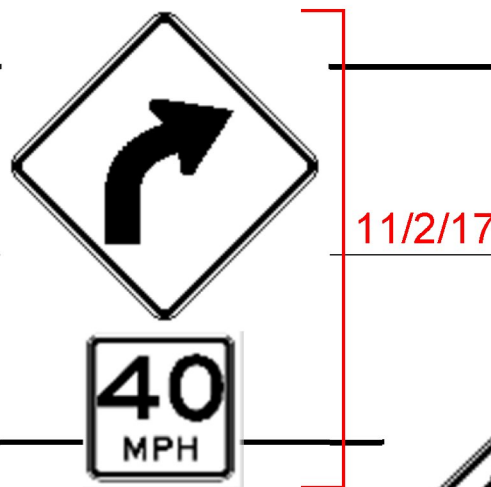
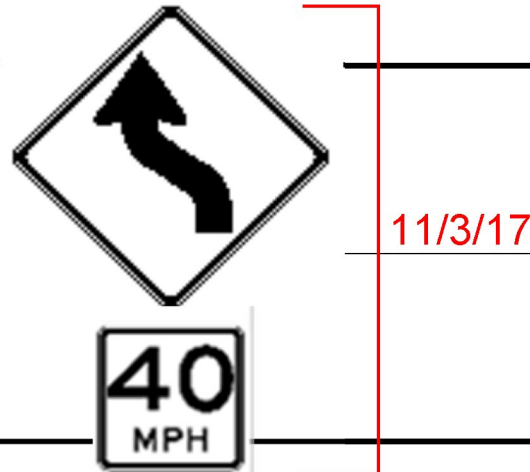


DIRECTION	MILEPOINT	LOCATION CODE (SHEET 4)	SIGN CODE	WIDTH (IN)	HEIGHT (IN)	SHEETING REMARKS	SIGN LEGEND	NEW SIGNS		EXISTING SIGNS				EXIST POST		NUMBER OF NEW POSTS	SQUARE STEEL (IN)			TUBULAR STEEL Ø (IN)				SIGN FRAME REQUIRED	REMARKS	SIGN DETAIL LOCATION			
								"A"	"B"	RETAIN	SALVAGE FROM	SALVAGE TO	REMOVE	RETAIN	REMOVE		1.75	2.00	2.50	FOUNDATION	3.00	3.50	4.00			5.00	SHSM	SIGN DETAILS SHEET #	STANDARD SHEET #
																	(LB / FT)				(LB / FT)								
																	1.88	2.42	3.35		7.60	9.00	10.80			14.60			
SB MT HOLLY VT 155							FY-FLUORESCENT YELLOW FYG-FLUORESCENT YELLOW GREEN															"SHSM"-STANDARD HIGHWAY SIGNS AND MARKINGS BOOK							
SB	0.920	F	W7-1a	30	30			6.25							1	17'-0" X								X					
		F	W7-3aP	24	18			3.00																X					
SB	0.445	F	VD-701					0.42					1	X												INSTALL ON RETAINED POST			T-42
		F	VD-701	6	10																								
SB	0.450	F	W1-2R	30	30	FY		6.25							1	15'-0" X								INSTALL 5' UPSTATION FROM GUARDRAIL END TREATMENT AT MP 0.450 SB	X				
		F	W13-1P	18	18	FY		2.25																	X				
SB	0.124	F	W1-4L	30	30	FY		6.25							1	17'-3" X								INSTALL 250' DOWNSTATION FROM GUARDRAIL END TREATMENT AT MP 0.170 SB	X				
		F	W13-1P	18	18	FY		2.25																	X				
SB	0.035	F	W1-2R				RIGHT CURVE						1		X														
		F	W13-1P				40 M.P.H.						1																
SB	0.031	G	VD-024				WESTON MOUNT HOLLY						1											INSTALL SIGNS ON NB SIDE OF ROAD (SEE NB MT HOLLY PLANS)					
		G	VD-025				WINDSOR CO RUTLAND CO						1																
		G	VD-700				MILE MARKER 1550/1421/0228						1																
		G	VD-700				MILE MARKER 1550/1421/0000						1																
SIGN SUMMARY SHEET							SHEET TOTALS	26.67	0.00	0	0	0	7	0	0	3	45.0	0	0.0	0.0	0.0	0.0	PROJECT NAME: STATEWIDE-SOUTH REGION						
								SF	SF	EA	EA	EA	EA	EA	EA	EA	FT	EA	LB	LB	LB	LB	PROJECT NUMBER: STPG SIGN(57)						
																						FILE NAME: z16t041Mt HollyVT155 SB.xls	PLOT DATE: 2/27/2017						
VERMONT AGENCY OF TRANSPORTATION																						PROJECT MANAGER: D. MUNRO	DRAWN BY: W. GORDON						
							TOWN DIRECTIONAL TOTALS	171.1	0.0	7	3	3	39	0	0	32	465.0	0	0.0				DESIGNED BY: P. MCKECHNIE	CHECKED BRZEZOWSKI					
																						MOUNT HOLLY VT-155 SB 6	SHEET 256 OF 264						