

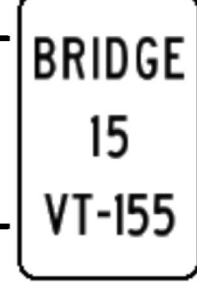





DIRECTION	MILEPOINT	LOCATION CODE (SHEET 4)	SIGN CODE	WIDTH (IN)	HEIGHT (IN)	SHEETING REMARKS	SIGN LEGEND	NEW SIGNS		EXISTING SIGNS			EXIST POST		NUMBER OF NEW POSTS	SQUARE STEEL (IN)			TUBULAR STEEL Ø (IN)				SIGN FRAME REQUIRED	REMARKS	SIGN DETAIL LOCATION				
								"A"	"B"	RETAIN	SALVAGE FROM	SALVAGE TO	REMOVE	RETAIN		REMOVE	1.75	2.00	2.50	FOUNDATION	3.00	3.50			4.00	5.00	SHSM	SIGN DETAILS SHEET #	STANDARD SHEET #
																	(LB / FT)				(LB / FT)								
SB WALLINGFORD VT RTE 155							FY-FLUORESCENT YELLOW FYG-FLUORESCENT YELLOW GREEN															"SHSM"-STANDARD HIGHWAY SIGNS AND MARKINGS BOOK							
SB	0.403	F	W5-2				NARROW BRIDGE																						
		E	R1-1				STOP																						
		F	W5-2	30	30		 10/27/17	6.25														14'-0" X		X					
SB	0.392	F	M3-3																										
		F	VM1-5				 10/27/17																						
		F	M3-3	24	12			2.00														13'-0" X		X					
		F	VM1-5	30	24			5.00																	E-136				
SB	0.390	F	VD-701	6	10		 10/27/17	0.42														7'-3" X			T-42				
SB	0.389	F	OM3-R				RIGHT OBJECT MARKER																						
		F	VD-701																										
		F	OM3-R	12	36		 10/27/17	3.00														10'-9" X		X					
SB	0.352	E	OM3-L				 10/27/17																						
		E	OM3-L	12	36			3.00														10'-9" X		X					
SB	0.348	F	R2-1	24	30		 10/27/17	5.00														13'-3" X		X					
SB	0.345	F	R2-1				SPEED LIMIT 30																						
SIGN SUMMARY SHEET							SHEET TOTALS	24.67	0.00	0	0	0	8	0	0	6	85.0	0	0.0	0.0	0.0	0.0	PROJECT NAME: STATEWIDE-SOUTH REGION PROJECT NUMBER: STPG SIGN(57)						
VERMONT AGENCY OF TRANSPORTATION							TOWN DIRECTIONAL TOTALS	62.8	0.0	3	5	5	22	0	0	14	205.0	0		0.0			FILE NAME: z16t041Wallinaford155SB.xls PLOT DATE: 2/27/2017 PROJECT MANAGER: D. MUNRO DRAWN BY: W. GORDON DESIGNED BY: P. MCKECHNIE CHECKED: BRZEZOWSKA WALLINGFORD VT-155 SB 1 SHEET 260 OF 264						