


STATE OF VERMONT  
AGENCY OF TRANSPORTATION

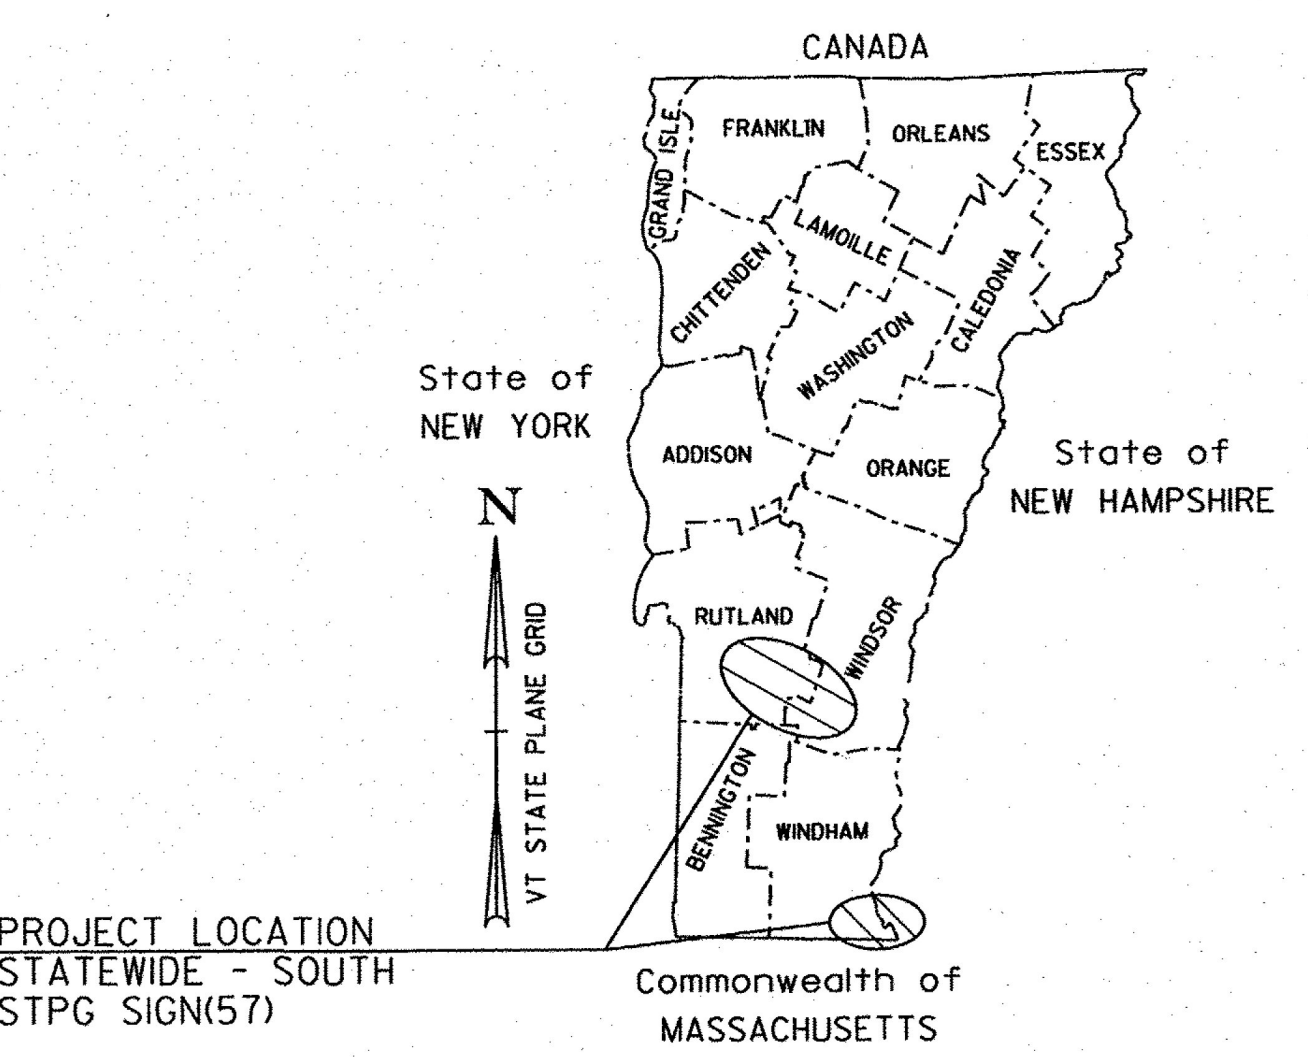

**Record Plans**  
Contractor: F.R. LAFAYETTE, INC.  
Resident Engineer: SHEAMUS FAGAN  
Construction Began: JULY 17, 2017  
Construction Complete: JULY 12, 2018  
Record Plans By: SHEAMUS FAGAN & JESSE IVES

I hereby certify that all construction required by this set of drawings has been accomplished as indicated herein.

BY: \_\_\_\_\_ Resident Engineer

Date: \_\_\_\_\_

NOTE: Any further information concerning final quantities, amounts or other details relative to this project may be found at Central Files in the electronic archives.

PROPOSED IMPROVEMENT

TOWNS OF WALLINGFORD, CLARENDON, MOUNT HOLLY,  
SHREWSBURY, LUDLOW, WESTON, BRATTLEBORO & VERNON  
COUNTIES OF RUTLAND, WINDSOR, AND WINDHAM  
VT ROUTE 7B (MAJOR COLLECTOR)  
VT ROUTE 103 (PRINCIPAL ARTERIAL) (NHS)  
VT ROUTE 140 (MAJOR COLLECTOR)  
VT ROUTE 155 (MAJOR COLLECTOR)  
VT ROUTE 142 (MAJOR COLLECTOR)

**VT ROUTE 7B:**  
BEGINNING IN THE TOWN OF WALLINGFORD AT THE INTERSECTION OF US ROUTE 7 AND VT ROUTE 7B AT MILE MARKER 0.000 AND EXTENDING NORTHERLY ALONG VT ROUTE 7B FOR 5.180 MILES THROUGH THE TOWNS OF WALLINGFORD AND CLARENDON TO THE INTERSECTION OF US ROUTE 7 AND VT ROUTE 7B IN CLARENDON AT MILE MARKER 4.406.

**VT ROUTE 103:**  
BEGINNING IN THE TOWN OF LUDLOW AT THE TOWN LINE OF CAVENDISH AND LUDLOW AT MILE MARKER 0.000 AND EXTENDING NORTHERLY ALONG VT ROUTE 103 STOPPING IN LUDLOW AT MILE POINT 4.015 AND RESUMING APPROXIMATELY 1330 FEET NORTH AT MILE POINT 4.267 IN LUDLOW FOR A TOTAL OF 21.560 MILES THROUGH THE TOWNS OF LUDLOW, MOUNT HOLLY, WALLINGFORD, SHREWSBURY AND CLARENDON TO THE INTERSECTION OF US ROUTE 7 AND VT ROUTE 103 IN CLARENDON AT MILE MARKER 1.979.

**VT ROUTE 140:**  
BEGINNING IN THE TOWN OF WALLINGFORD AT THE INTERSECTION OF US ROUTE 7 AND VT ROUTE 140 AT MILE MARKER 0.000 AND EXTENDING EASTERLY ALONG VT ROUTE 140 FOR 6.495 MILES THROUGH THE TOWNS OF WALLINGFORD AND MOUNT HOLLY TO THE INTERSECTION OF VT ROUTE 103 AND VT ROUTE 140 IN MOUNT HOLLY AT MILE MARKER 0.152.

**VT ROUTE 155:**  
BEGINNING IN THE TOWN OF WESTON AT THE INTERSECTION OF VT ROUTE 100 AND VT ROUTE 155 AT MILE MARKER 0.000 AND EXTENDING NORTHERLY ALONG VT ROUTE 155 FOR 10.204 MILES THROUGH THE TOWNS OF WESTON, MOUNT HOLLY AND WALLINGFORD TO THE INTERSECTION OF VT ROUTE 103 AND VT ROUTE 155 IN WALLINGFORD AT MILE MARKER 0.412 (EXCLUDES 0.086 MILES CO-JOINED WITH VT ROUTE 140).


**VT ROUTE 142:**  
BEGINNING IN THE TOWN OF VERNON AT THE STATE LINE OF VERMONT AND THE COMMONWEALTH OF MASSACHUSETTS AT MILE MARKER 0.000 AND EXTENDING NORTHERLY ALONG VT ROUTE 142 FOR 10.847 MILES THROUGH THE TOWNS OF VERNON AND BRATTLEBORO TO THE INTERSECTION OF US ROUTE 5 AND VT ROUTE 142 IN BRATTLEBORO AT MILE MARKER 2.167.


CONSTRUCTION IS TO BE CARRIED ON IN ACCORDANCE WITH THESE PLANS AND THE STANDARD SPECIFICATIONS FOR CONSTRUCTION DATED 2011, AS APPROVED BY THE FEDERAL HIGHWAY ADMINISTRATION ON JULY 20, 2011 FOR USE ON THIS PROJECT, INCLUDING ALL SUBSEQUENT REVISIONS AND SUCH REVISED SPECIFICATIONS AND SPECIAL PROVISIONS AS ARE INCORPORATED IN THESE PLANS.

LENGTH OF PROJECT = 54.286 MILES (SEE SUMMARY ON SHEET 3)

WORK TO BE PERFORMED UNDER THIS PROJECT INCLUDES THE REMOVAL OF EXISTING SIGNS AND POSTS AND THE INSTALLATION OF NEW SIGNS AND SIGN POSTS AND OTHER HIGHWAY RELATED ITEMS.

|                                     |     |
|-------------------------------------|-----|
| QUALITY ASSURANCE PROGRAM : LEVEL I |     |
| SURVEYED BY : N/A                   |     |
| SURVEYED DATE : N/A                 |     |
| DATUM                               |     |
| VERTICAL                            | N/A |
| HORIZONTAL                          | N/A |

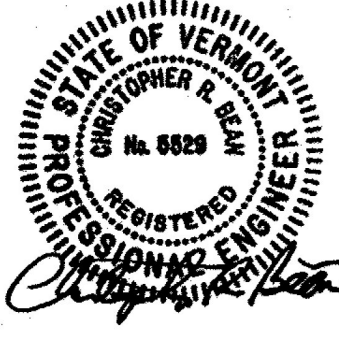

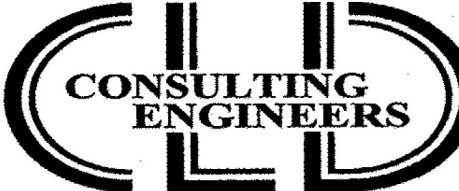

540 Commercial Street  
Manchester, NH 03101  
(603) 668-8223  
www.cldengineers.com

|                                             |
|---------------------------------------------|
| DIRECTOR OF PROJECT DELIVERY                |
| APPROVED: <i>[Signature]</i> DATE: 3/2/2017 |
| PROJECT MANAGER : PATRICIA COBURN, P.E.     |
| PROJECT NAME : STATEWIDE-SOUTH REGION       |
| PROJECT NUMBER : STPG SIGN(57)              |
| SHEET 1 OF 264 SHEETS                       |