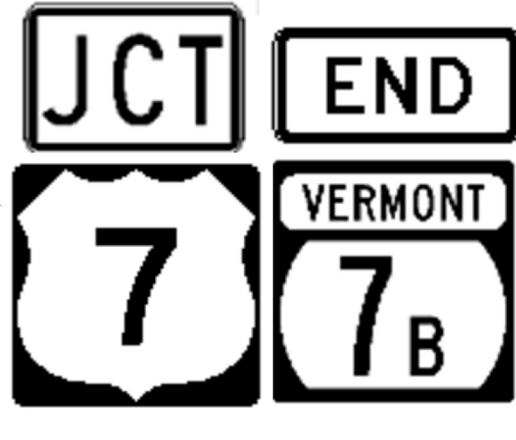


DIRECTION	MILEPOINT	LOCATION CODE (SHEET 4)	SIGN CODE	WIDTH (IN)	HEIGHT (IN)	SHEETING REMARKS	SIGN LEGEND	NEW SIGNS		EXISTING SIGNS				EXIST POST		NUMBER OF NEW POSTS	SQUARE STEEL (IN)			TUBULAR STEEL Ø (IN)				SIGN FRAME REQUIRED	REMARKS	SIGN DETAIL LOCATION			
								"A"	"B"	RETAIN	SALVAGE FROM	SALVAGE TO	REMOVE	RETAIN	REMOVE		1.75	2.00	2.50	FOUNDATION	3.00	3.50	4.00			5.00	SHSM	SIGN DETAILS SHEET #	STANDARD SHEET #
																	(LB / FT)				(LB / FT)								
																	1.88	2.42	3.35		7.60	9.00	10.80			14.60			
SB WALLINGFORD VT ROUTE 7B							FY-FLUORESCENT YELLOW FYG-FLUORESCENT YELLOW GREEN															"SHSM"-STANDARD HIGHWAY SIGNS AND MARKINGS BOOK							
SB	0.140	F	W3-1				 7/18/17						1	X															
		F	W3-1	30	30			6.25																INSTALL ON RETAINED POST THINNING AND TRIMMING	X				
SB	0.090	F	M2-1				 11/27/17						1	X	X														
		F	M1-4										1																
		F	M4-6										1																
		F	VM1-5										1																
		F	M2-1	21	15			2.19										14'-3" 12'-9" X						2A	INSTALL ON RETAINED POSTS JCT, BLACK ON WHITE	X			
		F	M1-4	24	24			4.00																	X				
		F	M4-6	24	12			2.00																	X				
		F	VM1-5	24	24			4.00																			E-136		
SB	0.050	F	M3-1										1	X	X														
		F	M1-4										1																
		F	M6-1L										1																
		F	M3-3										1																
		F	M1-4										1																
SIGN SUMMARY SHEET							SHEET TOTALS	18.44	0.00	0	0	0	10	0	0	0	0.0			0	0.0	0.0	0.0	0.0	PROJECT NAME: STATEWIDE-SOUTH REGION				
								SF	SF	EA	EA	EA	EA	EA	EA	EA		FT		EA	LB	LB	LB	LB	PROJECT NUMBER: STPG SIGN(57)				
																								FILE NAME: z16t041Wallinaford7B SB.xls					
VERMONT AGENCY OF TRANSPORTATION																								PLOT DATE: 2/27/2017					
							TOWN DIRECTIONAL TOTALS	63.2	0.0	5	2	2	20	0	0	5	75.0			0	0.0				DRAWN BY: W. GORDON				
																								CHECKED: BRZEZOWSKI					
																								SHEET 18 OF 264					