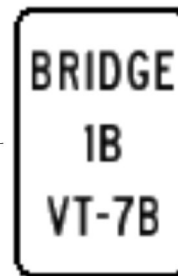
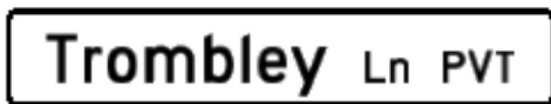
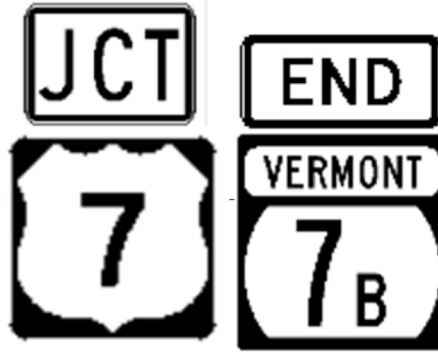


DIRECTION	MILEPOINT	LOCATION CODE (SHEET 4)	SIGN CODE	WIDTH (IN)	HEIGHT (IN)	SHEETING REMARKS	SIGN LEGEND	NEW SIGNS		EXISTING SIGNS				EXIST POST		NUMBER OF NEW POSTS	SQUARE STEEL (IN)			TUBULAR STEEL Ø (IN)				SIGN FRAME REQUIRED	REMARKS	SIGN DETAIL LOCATION			
								"A"	"B"	RETAIN	SALVAGE FROM	SALVAGE TO	REMOVE	RETAIN	REMOVE		1.75	2.00	2.50	FOUNDATION	3.00	3.50	4.00			5.00	SHSM	SIGN DETAILS SHEET #	STANDARD SHEET #
																	(LB / FT)				(LB / FT)								
																	1.88	2.42	3.35		7.60	9.00	10.80			14.60			
NB CLARENDON VT ROUTE 7B							FY-FLUORESCENT YELLOW FYG-FLUORESCENT YELLOW GREEN															"SHSM"-STANDARD HIGHWAY SIGNS AND MARKINGS BOOK							
		A	M3-1	24	12		 7/20/17	2.00							1		13'-0" X							NORTH, GREEN ON WHITE	X				
		A	VM1-5	24	24			4.00																		E-136			
NB	2.996	A	R2-1				 7/20/17					1		X															
		A	R2-1	24	30			5.00							1		12'-0" X								X				
NB	3.371	C	VR-278				PROHIBITED						1		X														
NB	3.381	A	VD-701				 7/20/17						1		X														
		A	VD-701	6	10			0.42							1		6'-9" X									T-42			
NB	3.621	AB	D3-1				 7/20/17						1		X														
		AB	D3-1	68	12			5.67							2		11'-3" 10'-3" X									6			
NB	3.751	A	R2-1				 7/20/17						1		X														
		A	R2-1	24	30			5.00							1		11'-3" X								X				
NB	4.298	A	M2-1	21	15			2.19							2		14'-9" 13'-6" X						2A	JCT, BLACK ON WHITE	X				
		A	M1-4	24	24		 11/17/17	4.00																INSTALL 200' DOWNSTATION FROM EXISTING SIGN AT MP 4.336 NB	X				
		A	M4-6	24	12			2.00																END, GREEN ON WHITE	X				
		A	VM1-5	24	24			4.00																		E-136			
SIGN SUMMARY SHEET							SHEET TOTALS	34.27	0.00	0	0	0	5	0	0	8		115.0		0	0.0	0.0	0.0	0.0	PROJECT NAME: STATEWIDE-SOUTH REGION	PROJECT NUMBER: STPG SIGN(57)			
								SF	SF	EA	EA	EA	EA	EA	EA	EA		FT		EA	LB	LB	LB	LB					
VERMONT AGENCY OF TRANSPORTATION							TOWN DIRECTIONAL TOTALS	202.9	0.0	5	0	0	40	0	0	27		370.0		2	288.0				FILE NAME: z16t041Clarendon7B NB.xls	PLOT DATE: 2/27/2017			
																											PROJECT MANAGER: D. MUNRO	DRAWN BY: W. GORDON	
																							DESIGNED BY: P. MCKECHNIE	CHECKED: BRZEZOWSKI					
																							CLARENDON VT-7B NB 6	SHEET 25 OF 264					