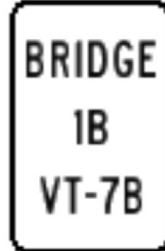


DIRECTION	MILEPOINT	LOCATION CODE (SHEET 4)	SIGN CODE	WIDTH (IN)	HEIGHT (IN)	SHEETING REMARKS	SIGN LEGEND	NEW SIGNS		EXISTING SIGNS				EXIST POST		NUMBER OF NEW POSTS	SQUARE STEEL (IN)			TUBULAR STEEL Ø (IN)				SIGN FRAME REQUIRED	REMARKS	SIGN DETAIL LOCATION									
								"A"	"B"	RETAIN	SALVAGE FROM	SALVAGE TO	REMOVE	RETAIN	REMOVE		1.75	2.00	2.50	FOUNDATION	3.00	3.50	4.00			5.00	SHSM	SIGN DETAILS SHEET #	STANDARD SHEET #						
																	(LB / FT)				(LB / FT)														
																	1.88	2.42	3.35		7.60	9.00	10.80			14.60									
SB CLARENDON VT ROUTE 7B							FY-FLUORESCENT YELLOW FYG-FLUORESCENT YELLOW GREEN															"SHSM"-STANDARD HIGHWAY SIGNS AND MARKINGS BOOK													
SB	4.411	F	M3-3				 7/20/17					1		X																					
		F	VM1-5										1																						
		F	M3-3	24	12			2.00									1		13'-3" X								SOUTH, GREEN ON WHITE	X							
		F	VM1-5	24	24			4.00																				E-136							
SB	4.373	F	R2-1	24	30		 7/20/17	5.00								1		12'-6" X									INSTALL 195' DOWNSTATION FROM EXIST. SIGN AT MP 4.411 SB	X							
SB	4.336	F	R2-1										1		X																				
SB	3.716	F	R2-1				 7/20/17						1	X																					
		F	R2-1	24	30			5.00																		INSTALL SIGN ON RETAINED POST	X								
SB	3.586	F	W1-2L				LEFT CURVE  45 MPH 7/20/17						1		X																				
		F	W13-1P										1																						
SB	3.526	F	W1-2L	30	30		 7/20/17	6.25								1		14'-0" X								INSTALL SIGN 315' DOWNSTATION FROM EXIST. SIGN AT MP 3.586 SB	X								
SB	3.415	F	VD-701										1		X																				
		F	VD-701	6	10	 7/20/17		0.42								1		8'-6" X										T-42							
SB	3.191	F	W2-1										1		X																				
SB	3.071	FE	D3-1										1		X																				
SIGN SUMMARY SHEET							SHEET TOTALS	22.67	0.00	0	0	0	9	0	0	4		55.0		0	0.0	0.0	0.0	0.0	PROJECT NAME: STATEWIDE-SOUTH REGION	PROJECT NUMBER: STPG SIGN(57)			VERMONT AGENCY OF TRANSPORTATION						
								SF	SF	EA	EA	EA	EA	EA	EA	EA		FT		EA	LB	LB	LB	LB											
																															FILE NAME: z16t041Clarendon7B SB.xls	PLOT DATE: 2/27/2017			
							TOWN DIRECTIONAL TOTALS	154.3	0.0	1	0	0	37	0	0	17		220.0		2		279.0		DESIGNED BY: P. MCKECHNIE											
																									CLARENDON VT-7B SB 1	DRAWN BY: W. GORDON									
																										BRZEZOWSKI	CHECKED SHEET 27 OF 264								