
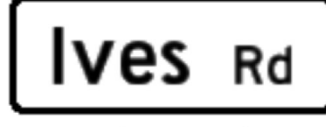






DIRECTION	MILEPOINT	LOCATION CODE (SHEET 4)	SIGN CODE	WIDTH (IN)	HEIGHT (IN)	SHEETING REMARKS	SIGN LEGEND	NEW SIGNS		EXISTING SIGNS			EXIST POST	NUMBER OF NEW POSTS	SQUARE STEEL (IN)			TUBULAR STEEL Ø (IN)				SIGN FRAME REQUIRED	REMARKS	SIGN DETAIL LOCATION					
								"A"	"B"	RETAIN	SALVAGE FROM	SALVAGE TO	REMOVE		RETAIN	REMOVE	1.75	2.00	2.50	FOUNDATION	3.00			3.50	4.00	5.00	SHSM	SIGN DETAILS SHEET #	STANDARD SHEET #
																	(LB / FT)				(LB / FT)								
NB LUDLOW VT ROUTE 103							FY-FLUORESCENT YELLOW FYG-FLUORESCENT YELLOW GREEN														"SHSM"-STANDARD HIGHWAY SIGNS AND MARKINGS BOOK								
NB	0.231	C	VR-017				 8/9/17					1	X								IVES RD (TH-70)								
		C	VR-017	24	30																INSTALL ON RETAINED POST			T-70					
NB	0.236	AB	D3-1				IVES RD					1	X	X															
		D	R1-1				STOP					1																	
		C	VD-700				MILE MARKER 1030 / 1410 / 0022					1																	
		AB	D3-1	32	12		 8/9/17														INSTALL ABOVE STOP SIGN		6						
		D	R1-1	30	30		 8/9/17														INSTALL ON RETAINED POST	X							
NB	0.353	A	VW-205				 8/10/17					1		X															
		A	VW-205	36	36																			T-82					
NB	0.400	A	R2-1				 8/10/17					1		X															
		A	R2-1	24	30																		X						
NB	0.576	C	VR-017				 8/9/17					1		X							BIXBY RD (TH-6)								
		C	VR-017	24	30																INSTALL NEW SIGN IN SAME LOCATION ON BIXBY RD			T-70					
NB	0.576	AB	D3-1				Bixby Rd 8/9/17					1									INSTALL INDEPENDENTLY ON ONE POST ON THE LEGAL LOAD SIDE OF THE INTERSECTION								
SIGN SUMMARY SHEET							SHEET TOTALS	32.92	0.00	1	0	1	6	0	0	5	75.0	0	0.0	0.0	0.0	0.0	PROJECT NAME: STATEWIDE-SOUTH REGION						
								SF	SF	EA	EA	EA	EA	EA	EA	EA	FT	EA	LB	LB	LB	LB	PROJECT NUMBER: STPG SIGN(57)						
VERMONT AGENCY OF TRANSPORTATION							TOWN DIRECTIONAL TOTALS	754.3	0.0	42	13	13	190	0	0	65	945.0	0		0.0			FILE NAME: z16t041Ludlow 103 NB.xls	PLOT DATE: 2/27/2017					
																						PROJECT MANAGER: D. MUNRO	DRAWN BY: W. GORDON						
																						DESIGNED BY: P. MCKECHNIE	CHECKED: BRZEZOWSKA						
																						LUDLOW VT-103 NB 2	SHEET 34	OF 264					