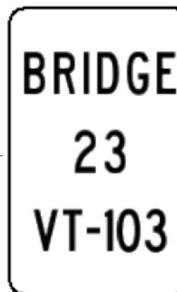


DIRECTION	MILEPOINT	LOCATION CODE (SHEET 4)	SIGN CODE	WIDTH (IN)	HEIGHT (IN)	SHEETING REMARKS	SIGN LEGEND	NEW SIGNS		EXISTING SIGNS				EXIST POST		NUMBER OF NEW POSTS	SQUARE STEEL (IN)			TUBULAR STEEL Ø (IN)				SIGN FRAME REQUIRED	REMARKS	SIGN DETAIL LOCATION			
								"A"	"B"	RETAIN	SALVAGE FROM	SALVAGE TO	REMOVE	RETAIN	REMOVE		1.75	2.00	2.50	FOUNDATION	3.00	3.50	4.00			5.00	SHSM	SIGN DETAILS SHEET #	STANDARD SHEET #
																	(LB / FT)				(LB / FT)								
																	1.88	2.42	3.35		7.60	9.00	10.80			14.60			
NB LUDLOW VT ROUTE 103							FY-FLUORESCENT YELLOW FYG-FLUORESCENT YELLOW GREEN															"SHSM"-STANDARD HIGHWAY SIGNS AND MARKINGS BOOK							
NB	0.916	A	W11-6				 8/9/17						1		X														
			W11-6	30	30			6.25						1			12'-3" X								HINGED / FOLDING SIGN	X			
NB	0.935	C	VR-017				 8/9/17						1	X												DEROO LN (TH-20)			
		C	VR-017	24	30			5.00																		INSTALL ON RETAINED POST			T-70
NB	0.938	D	R1-1										1	X															
		C	VD-700							1																			
		D	R1-1	30	30		 8/9/17	6.25																		THINNING AND TRIMMING INSTALL ON RETAINED POST	X		
NB	0.948	AB																											
		AB	D3-1	40	12		 8/9/17	3.33								1		9'-3" X								INSTALL AT SAME LOCATION AS EXISTING		6	
NB	0.951	A	VD-701				 8/10/17						1		X														
		A	VD-701	6	10			0.42								1		7'-6" X										T-42	
NB	1.011	A	M3-1										1		X														
		A	VM1-5										1																
		A										1	1													SALVAGE TO NEW POST AT SAME LOCATION			
SIGN SUMMARY SHEET							SHEET TOTALS		21.25	0.00	1	1	0	8	0	0	3		40.0	0	0.0	0.0	0.0	0.0	PROJECT NAME: STATEWIDE-SOUTH REGION				
									SF	SF	EA	EA	EA	EA	EA	EA	EA		FT	EA	LB	LB	LB	LB	PROJECT NUMBER: STPG SIGN(57)				
																									FILE NAME: z16t041Ludlow 103 NB.xls				
VERMONT AGENCY OF TRANSPORTATION																							PLOT DATE: 2/27/2017						
																									DRAWN BY: W. GORDON				
TOWN DIRECTIONAL TOTALS																							CHECKED: BRZEWOSKI						
									754.3	0.0	42	13	13	190	0	0	65		945.0	0		0.0			SHEET 36 OF 264				