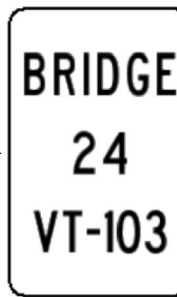
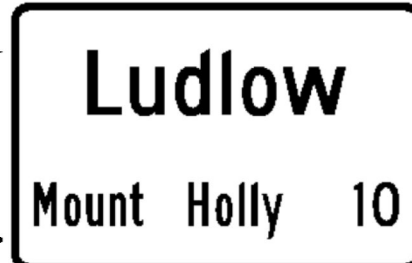


DIRECTION	MILEPOINT	LOCATION CODE (SHEET 4)	SIGN CODE	WIDTH (IN)	HEIGHT (IN)	SHEETING REMARKS	SIGN LEGEND	NEW SIGNS		EXISTING SIGNS				EXIST POST		NUMBER OF NEW POSTS	SQUARE STEEL (IN)			TUBULAR STEEL Ø (IN)				SIGN FRAME REQUIRED	REMARKS	SIGN DETAIL LOCATION				
								"A"	"B"	RETAIN	SALVAGE FROM	SALVAGE TO	REMOVE	RETAIN	REMOVE		1.75	2.00	2.50	FOUNDATION	3.00	3.50	4.00			5.00	SHSM	SIGN DETAILS SHEET #	STANDARD SHEET #	
																	(LB / FT)				(LB / FT)									
																	1.88	2.42	3.35		7.60	9.00	10.80			14.60				
NB LUDLOW VT ROUTE 103							FY-FLUORESCENT YELLOW FYG-FLUORESCENT YELLOW GREEN															"SHSM"-STANDARD HIGHWAY SIGNS AND MARKINGS BOOK								
NB	1.056	A	VD-701				 8/10/17						1		X															
		A	VD-701	6	10			0.42							1		7'-9" X												T-42	
NB	1.074	A	VD-062B				OFFICIAL BUSINESS DIRECTIONAL SIGN			1				X										Catholic Church right at light						
		A	VD-062B				OFFICIAL BUSINESS DIRECTIONAL SIGN			1														Academy Museum rt. At vets mem. pk						
NB	1.199	A	W3-5				REDUCE SPEED LIMIT 30 AHEAD						1		X															
		A	VD-700				MILE MARKER 1030 / 1410 / 0120				1		1																	
		A	W3-5	36	36		 8/10/17	9.00								2	12'-6" X 12'-6" X								X					
NB	1.200	A	VD-700				8/11/17 MILE MARKER 1030 / 1410 / 0120					1				1	7'-0" X													
NB	1.263	A	VD-018				LUDLOW MT. HOLLY 9						1	X																
			VD-018	36	24		 8/10/17	6.00																	INSTALL ON RETAINED POST				T-95	
NB	1.303	A	VR-038				STATE HIGHWAY ENDS						1		X									COORDINATE WITH TOWN TO HAVE RADAR SPEED DISPLAY SIGN INSTALLED.						
		A	R2-1				 4/9/18						1											PROVIDE 7' MINIMUM CLEAR HEIGHT						
		A	VR-038	24	18		 10/23/17	3.00								1			X						SLIP BASE REQUIRED-SEE SHEET 4 TOWN INSTALLED NEW RADAR ASSEMBLY ON TWO REGULAR-SIZED POSTS. VTRANS INSTALLED NEW SIGNS ON THESE POSTS.				T-71	
		A	R2-1	30	36			7.50																	X					
SIGN SUMMARY SHEET						SHEET TOTALS		25.92	0.00	2	1	1	6	0	0	5	65.0			0	0.0	0.0	0.0	0.0	PROJECT NAME: STATEWIDE-SOUTH REGION		PROJECT NUMBER: STPG SIGN(57)			VERMONT AGENCY OF TRANSPORTATION
							SF	SF	EA	EA	EA	EA	EA	EA	EA		FT		EA	LB	LB	LB	LB							
						TOWN DIRECTIONAL TOTALS		754.3	0.0	42	13	13	190	0	0	65	945.0			0	0.0				FILE NAME: z16t041Ludlow 103 NB.xls					PLOT DATE: 2/27/2017
																												PROJECT MANAGER: D. MUNRO		DRAWN BY: W. GORDON
																							DESIGNED BY: P. MCKECHNIE		CHECKED: BRZEZOWSKI					
																							LUDLOW VT-103 NB 6		SHEET 38 OF 264					