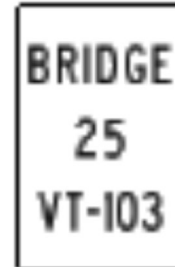
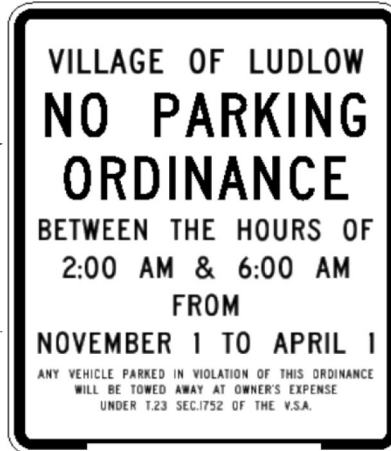


DIRECTION	MILEPOINT	LOCATION CODE (SHEET 4)	SIGN CODE	WIDTH (IN)	HEIGHT (IN)	SHEETING REMARKS	SIGN LEGEND	NEW SIGNS		EXISTING SIGNS				EXIST POST		NUMBER OF NEW POSTS	SQUARE STEEL (IN)			TUBULAR STEEL Ø (IN)				SIGN FRAME REQUIRED	REMARKS	SIGN DETAIL LOCATION					
								"A"	"B"	RETAIN	SALVAGE FROM	SALVAGE TO	REMOVE	RETAIN	REMOVE		1.75	2.00	2.50	FOUNDATION	3.00	3.50	4.00			5.00	SHSM	SIGN DETAILS SHEET #	STANDARD SHEET #		
																	(LB / FT)				(LB / FT)										
																	1.88	2.42	3.35		7.60	9.00	10.80			14.60					
NB LUDLOW VT ROUTE 103							FY-FLUORESCENT YELLOW FYG-FLUORESCENT YELLOW GREEN															"SHSM"-STANDARD HIGHWAY SIGNS AND MARKINGS BOOK									
NB	1.946	A	VD-701				 8/18/17					1	X																		
		A	VD-701	6	10			0.42																		INSTALL ON RETAINED POST			T-42		
NB	1.956	A	W11-2				 8/18/17					1	X																		
		A	W16-7pL										1																		
		A	W11-2	30	30	FYG		6.25																		INSTALL ON RETAINED POST PROVIDE 7' MINIMUM CLEAR HEIGHT	X				
		A	W16-7pL	24	12	FYG		2.00																			X				
NB	2.000	A	R2-1	24	30		 8/29/17	5.00							1		12'-6" X									INSTALL SIGN BEHIND SIDEWALK AND 10' UPSTATION FROM WALKWAY TO TDS TELECOM (111 MAIN ST) PROVIDE 7' MINIMUM CLEAR HEIGHT	X				
NB	2.036	C						 8/29/17					1		X												RETURN SIGN TO TOWN				
		C												1													RETURN SIGN TO TOWN				
		C		30	36		7.50									1		14'-0" X								~~INSTALL POST IN SAME LOCATION BEHIND CURB. PROVIDE 8' MINIMUM CLEAR HEIGHT~~		3			
		C		12	18		1.50																			SIGN INSTALLED AT PROPERTY LINE DUE TO COMPLAINT		3			
NB	2.051	A	W11-2				 8/29/17					1	X																		
		A	W16-7pL										1																		
		A											1													RETURN SIGN TO TOWN					
SIGN SUMMARY SHEET						SHEET TOTALS		22.67	0.00	0	0	0	8	0	0	2		30.0		0	0.0	0.0	0.0	0.0	PROJECT NAME: STATEWIDE-SOUTH REGION PROJECT NUMBER: STPG SIGN(57)						
								SF	SF	EA	EA	EA	EA	EA	EA	EA		FT		EA	LB		LB	LB	LB	FILE NAME: z16t041Ludlow 103 NB.xls PROJECT MANAGER: D. MUNRO DESIGNED BY: P. MCKECHNIE LUDLOW VT-103 NB 11			PLOT DATE: 2/27/2017 DRAWN BY: W. GORDON CHECKED: BRZEZOWSKI SHEET 43 OF 264		
VERMONT AGENCY OF TRANSPORTATION						TOWN DIRECTIONAL TOTALS		754.3	0.0	42	13	13	190	0	0	65		945.0		0		0.0									