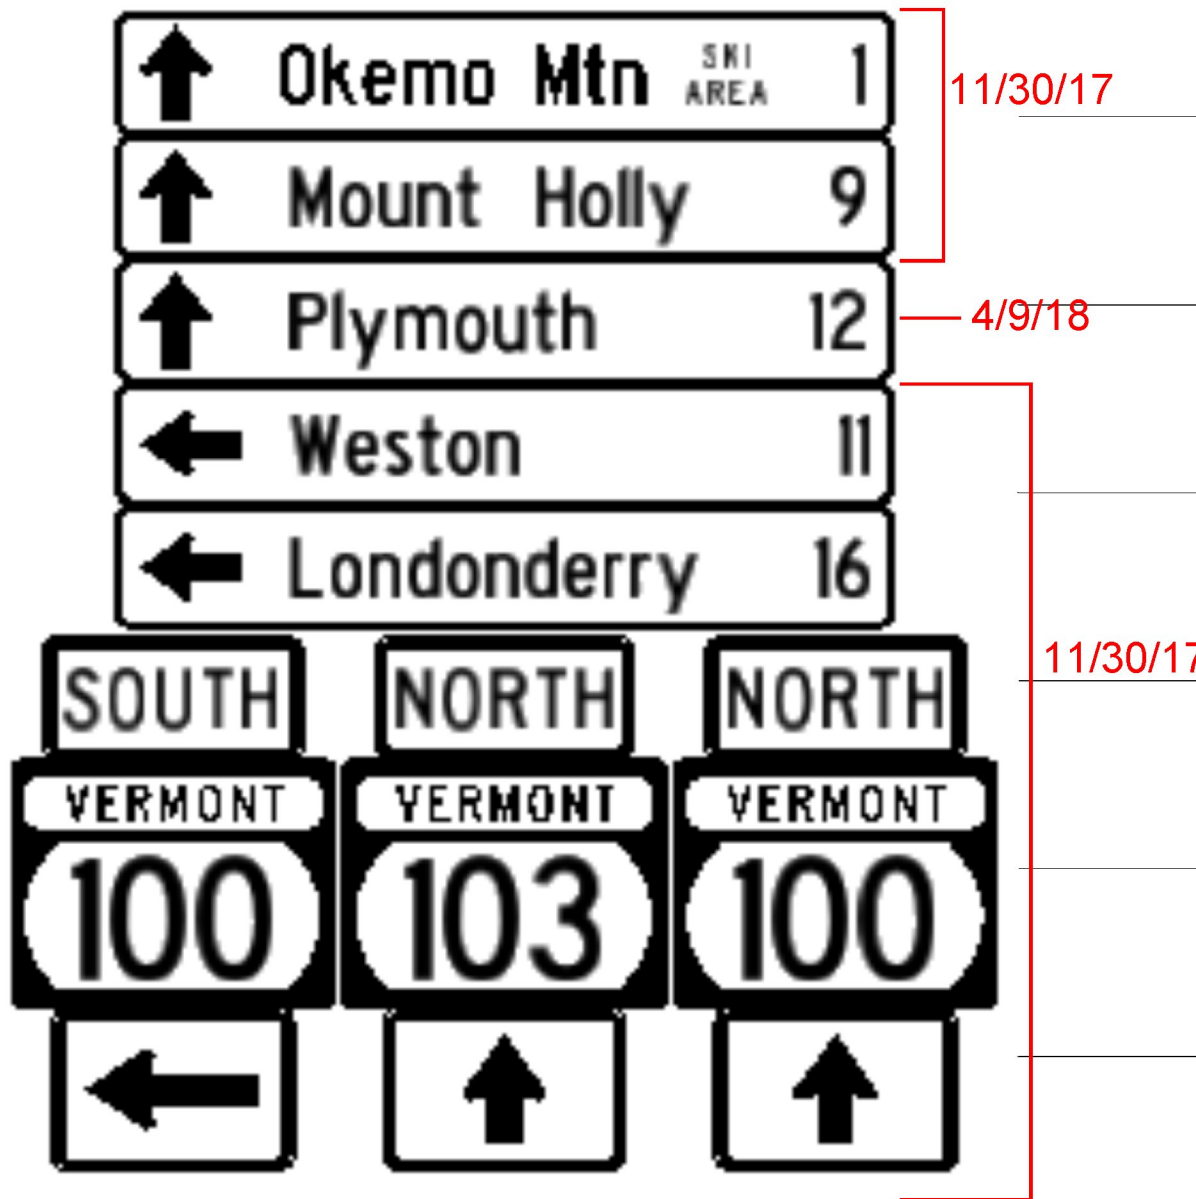


DIRECTION	MILEPOINT	LOCATION CODE (SHEET 4)	SIGN CODE	WIDTH (IN)	HEIGHT (IN)	SHEETING REMARKS	SIGN LEGEND	NEW SIGNS		EXISTING SIGNS				EXIST POST		NUMBER OF NEW POSTS	SQUARE STEEL (IN)			TUBULAR STEEL Ø (IN)				SIGN FRAME REQUIRED	REMARKS	SIGN DETAIL LOCATION			
								"A"	"B"	RETAIN	SALVAGE FROM	SALVAGE TO	REMOVE	RETAIN	REMOVE		1.75	2.00	2.50	FOUNDATION	3.00	3.50	4.00			5.00	SHSM	SIGN DETAILS SHEET #	STANDARD SHEET #
																	(LB / FT)				(LB / FT)								
																	1.88	2.42	3.35		7.60	9.00	10.80			14.60			
NB LUDLOW VT ROUTE 103							FY-FLUORESCENT YELLOW FYG-FLUORESCENT YELLOW GREEN															"SHSM"-STANDARD HIGHWAY SIGNS AND MARKINGS BOOK							
NB	2.240	A	VD1-1aSa	72	12			6.00															INSTALL ON RETAINED POSTS PROVIDE 7' MINIMUM CLEAR HEIGHT		3				
		A	VD1-1A	72	12			6.00																			T-93		
		A	VD1-1A	72	12			6.00																			T-93		
		A	VD1-1A	72	12			6.00																			T-93		
		A	VD1-1A	72	12			6.00																			T-93		
		A	M3-3	24	12			2.00													3D	SOUTH, GREEN ON WHITE	X						
		A	VM1-5	30	24			5.00																			E-136		
		A	M6-1	21	15			2.19																ARROW, GREEN ON WHITE	X				
		A	M3-1	24	12			2.00															NORTH, GREEN ON WHITE	X					
		A	VM1-5	30	24			5.00																			E-136		
		A	M6-3	21	15			2.19																ARROW, GREEN ON WHITE	X				
		A	M3-1	24	12			2.00																NORTH, GREEN ON WHITE	X				
		A	VM1-5	30	24			5.00																			E-136		
		A	M6-3	21	15			2.19																ARROW, GREEN ON WHITE	X				
NB	2.241	C	VD1-1A				<-- OKEMO MTN. SKI AREA 1						1	X															
SIGN SUMMARY SHEET						SHEET TOTALS		57.56	0.00	0	0	0	1	0	0	0	0.0			0	0.0	0.0	0.0	0.0	PROJECT NAME: STATEWIDE-SOUTH REGION				
								SF	SF	EA	EA	EA	EA	EA	EA	EA	FT			EA	LB	LB	LB	LB	PROJECT NUMBER: STPG SIGN(57)				
																										FILE NAME: z16t041Ludlow 103 NB.xls			
VERMONT AGENCY OF TRANSPORTATION						TOWN DIRECTIONAL TOTALS		754.3	0.0	42	13	13	190	0	0	65	945.0			0	0.0				PLOT DATE: 2/27/2017				
																									DRAWN BY: W. GORDON				
																							DESIGNED BY: P. MCKECHNIE						
																							PROJECT MANAGER: D. MUNRO						
																							CHECKED BRZEZOWSKI						
																							LUDLOW VT-103 NB 14						
																							SHEET 46 OF 264						