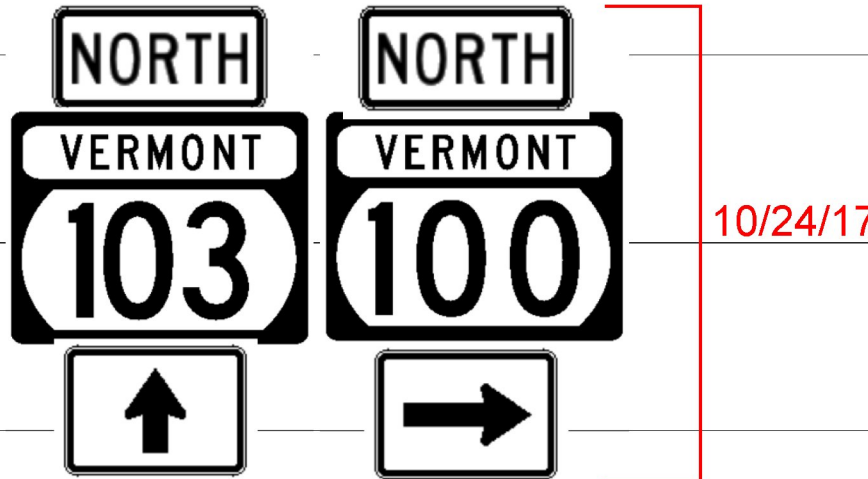


DIRECTION	MILEPOINT	LOCATION CODE (SHEET 4)	SIGN CODE	WIDTH (IN)	HEIGHT (IN)	SHEETING REMARKS	SIGN LEGEND	NEW SIGNS		EXISTING SIGNS				EXIST POST		NUMBER OF NEW POSTS	SQUARE STEEL (IN)			TUBULAR STEEL Ø (IN)				SIGN FRAME REQUIRED	REMARKS	SIGN DETAIL LOCATION							
								"A"	"B"	RETAIN	SALVAGE FROM	SALVAGE TO	REMOVE	RETAIN	REMOVE		1.75	2.00	2.50	FOUNDATION	3.00	3.50	4.00			5.00	SHSM	SIGN DETAILS SHEET #	STANDARD SHEET #				
																	(LB / FT)				(LB / FT)												
																	1.88	2.42	3.35		7.60	9.00	10.80			14.60							
NB LUDLOW VT ROUTE 103							FY-FLUORESCENT YELLOW FYG-FLUORESCENT YELLOW GREEN															"SHSM"-STANDARD HIGHWAY SIGNS AND MARKINGS BOOK											
		A	VM1-5				VERMONT 100					1																					
		A	M6-1				RIGHT ARROW					1																					
		A	M3-1	24	12			2.00														2C	INSTALL ON RETAINED POSTS NORTH, GREEN ON WHITE	X									
		A	VM1-5	30	24			5.00																					E-136				
		A	M6-3	21	15			2.19																UP ARROW, GREEN ON WHITE	X								
		A	M3-1	24	12			2.00																NORTH, GREEN ON WHITE	X								
		A	VM1-5	30	24			5.00																				E-136					
		A	M6-1	21	15			2.19																RIGHT ARROW, GREEN ON WHITE	X								
NB	3.952	J	R4-7				KEEP RIGHT					1	X																				
		J	OM1-1				OBJECT MARKER			1																							
		K	OM1-1				OBJECT MARKER			1																							
		JK					DELINEATORS			1														BACK TO BACK DELINEATORS									
		J	R4-7	24	30			5.00																	INSTALL ABOVE RETAINED OBJECT MARKER ON RETAINED POST	X							
NB	3.986	A	VR-922R				LANE ASSIGNMENT					1	X																				
		A	VR-922R	36	30			7.50																	INSTALL ON RETAINED POST				E-145				
SIGN SUMMARY SHEET						SHEET TOTALS		30.88	0.00	3	0	0	4	0	0	0	0.0			0	0.0	0.0	0.0	0.0	PROJECT NAME: STATEWIDE-SOUTH REGION			PROJECT NUMBER: STPG SIGN(57)					
								SF	SF	EA	EA	EA	EA	EA	EA	EA		FT			EA	LB	LB	LB	LB		FILE NAME: z16t041Ludlow 103 NB.xls			PLOT DATE: 2/27/2017			
																												PROJECT MANAGER: D. MUNRO			DRAWN BY: W. GORDON		
						VERMONT AGENCY OF TRANSPORTATION		TOWN DIRECTIONAL TOTALS		754.3	0.0	42	13	13	190	0	0	65	945.0			0	0.0				DESIGNED BY: P. MCKECHNIE			CHECKED: BRZEZOWSKI			
																								LUDLOW VT-103 NB 26			SHEET 58 OF 264						