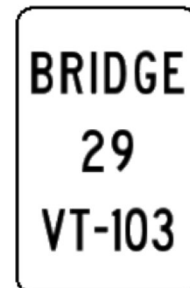


DIRECTION	MILEPOINT	LOCATION CODE (SHEET 4)	SIGN CODE	WIDTH (IN)	HEIGHT (IN)	SHEETING REMARKS	SIGN LEGEND	NEW SIGNS		EXISTING SIGNS				EXIST POST		NUMBER OF NEW POSTS	SQUARE STEEL (IN)			TUBULAR STEEL Ø (IN)				SIGN FRAME REQUIRED	REMARKS	SIGN DETAIL LOCATION			
								"A"	"B"	RETAIN	SALVAGE FROM	SALVAGE TO	REMOVE	RETAIN	REMOVE		1.75	2.00	2.50	FOUNDATION	3.00	3.50	4.00			5.00	SHSM	SIGN DETAILS SHEET #	STANDARD SHEET #
																	(LB / FT)				(LB / FT)								
																	1.88	2.42	3.35		7.60	9.00	10.80			14.60			
SB LUDLOW VT ROUTE 103							FY-FLUORESCENT YELLOW FYG-FLUORESCENT YELLOW GREEN															"SHSM"-STANDARD HIGHWAY SIGNS AND MARKINGS BOOK							
SB	4.323	G	R1-1				STOP			1				X															
SB	4.292	F	M2-1	21	15		 8/25/17	2.19							1		13'-9" X							JCT, GREEN ON WHITE INSTALL 240 FT ± NORTH OF EXISTING SIGN AT MP 4.251 SB	X				
		F	VM1-5	30	24			5.00																			E-136		
SB	4.280	F	VD-701				 10/25/17						1		X														
		F	VD-701	6	10			0.42							1		7'-0" X										T-42		
			MILE POINT 4.015 - 4.267 BEGIN BREAK IN SIGN PROJECT. RESUME PROJECT JUST BEYOND LOCUST ROAD																										
SB	3.980	F	VD2-1				OKEMO MTN SKI AREA 2						1		X														
		F	VD2-1				LUDLOW 2						1																
		F	VD2-1Sa	72	12		 8/28/17	6.00								2		14'-9" 13'-3" X									3		
		F	VD2-1	72	12		 8/28/17	6.00																				T-93	
SB	3.936	F	R2-1				 8/28/17						1	X															
		F	R2-1	24	30			5.00																	INSTALL ON RETAINED POST	X			
SB	3.901	F	VD-062B				OFFICIAL BUSINESS DIRECTIONAL SIGN			1				X											Okemo Valley Nordic Center				
		F	VD-062B				OFFICIAL BUSINESS DIRECTIONAL SIGN			1															The Okemo Inn				
SB	3.834	F	VD-062B				OFFICIAL BUSINESS DIRECTIONAL SIGN			1				X											Green Mountain at Fox Run				
SIGN SUMMARY SHEET						SHEET TOTALS		24.60	0.00	4	0	0	4	0	0	4		55.0		0	0.0	0.0	0.0	0.0	PROJECT NAME: STATEWIDE-SOUTH REGION				
								SF	SF	EA	EA	EA	EA	EA	EA	EA		FT		EA	LB	LB	LB	LB	PROJECT NUMBER: STPG SIGN(57)				
																								FILE NAME: z16t041Ludlow 103 SB.xls					
VERMONT AGENCY OF TRANSPORTATION						TOWN DIRECTIONAL TOTALS		502.1	0.0	48	5	5	120	0	0	62		870.0	2	217.0				PROJECT MANAGER: D. MUNRO			PLOT DATE: 2/27/2017		
																								DRAWN BY: W. GORDON					
																								DESIGNED BY: P. MCKECHNIE			CHECKED: BRZEZOWSKI		
																								LUDLOW VT-103 SB 2			SHEET 63 OF 264		