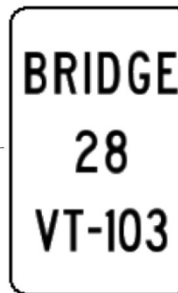


DIRECTION	MILEPOINT	LOCATION CODE (SHEET 4)	SIGN CODE	WIDTH (IN)	HEIGHT (IN)	SHEETING REMARKS	SIGN LEGEND	NEW SIGNS		EXISTING SIGNS				EXIST POST		NUMBER OF NEW POSTS	SQUARE STEEL (IN)			TUBULAR STEEL Ø (IN)				SIGN FRAME REQUIRED	REMARKS	SIGN DETAIL LOCATION			
								"A"	"B"	RETAIN	SALVAGE FROM	SALVAGE TO	REMOVE	RETAIN	REMOVE		1.75	2.00	2.50	FOUNDATION	3.00	3.50	4.00			5.00	SHSM	SIGN DETAILS SHEET #	STANDARD SHEET #
																	(LB / FT)				(LB / FT)								
																	1.88	2.42	3.35		7.60	9.00	10.80			14.60			
SB LUDLOW VT ROUTE 103							FY-FLUORESCENT YELLOW FYG-FLUORESCENT YELLOW GREEN															"SHSM"-STANDARD HIGHWAY SIGNS AND MARKINGS BOOK							
		F	VD-062B				OFFICIAL BUSINESS DIRECTIONAL SIGN			1													Okemo Valley Golf Club						
		F	VD-062B				OFFICIAL BUSINESS DIRECTIONAL SIGN			1													Willie Dunn's Grille						
SB	3.654	G					EMPTY POST							X									REMOVE POST. PAYMENT SHALL BE MADE UNDER ITEM 675.12 REMOVAL OF EXISTING DELINEATOR.						
SB	3.654	G	VR-017	24	30	 8/28/17		5.00							1		12'-3" X						LOCUST HILL RD (TH-52) INSTALL ON LEGAL LOAD SIDE OF THE TOWN HIGHWAY			T-70			
SB	3.654	FE	D3-1	56	12	 8/28/17		4.67							2		10'-6" X 10'-0" X						INSTALL INDEPENDENTLY ON TWO POSTS ON THE LEGAL LOAD SIDE OF THE INTERSECTION		6				
SB	3.644	FE	D3-1				LOCUST HILL TH 52						1	X															
		H	R2-1				STOP						1																
		G	VD-700				MILE MARKER 1030 / 1410 / 0365			1																			
		H	R1-1	30	30	 8/28/17		6.25															INSTALL ON RETAINED POST	X					
SB	3.529	F	VD-701				 8/22/17						1		X														
		F	VD-701	6	10			0.42							1		8'-3" X									T-42			
SB	3.330	F	VD-062B				OFFICIAL BUSINESS DIRECTIONAL SIGN			1				X									The Wine & Cheese Depot, rt. at light						
		F	VD-062B				OFFICIAL BUSINESS DIRECTIONAL SIGN			1													Andrie Rose Inn right at light						
SB	3.295	F	VD-062B				OFFICIAL BUSINESS DIRECTIONAL SIGN			1				X									Depot St. Gallery right at light						
SIGN SUMMARY SHEET						SHEET TOTALS		16.33	0.00	6	0	0	3	0	0	4		55.0	0	0.0	0.0	0.0	0.0	PROJECT NAME: STATEWIDE-SOUTH REGION					
								SF	SF	EA	EA	EA	EA	EA	EA	EA		FT		EA	LB	LB	LB	LB	PROJECT NUMBER: STPG SIGN(57)				
						TOWN DIRECTIONAL TOTALS		502.1	0.0	48	5	5	120	0	0	62		870.0	2	217.0				FILE NAME: z16t041Ludlow 103 SB.xls			PLOT DATE: 2/27/2017		
VERMONT AGENCY OF TRANSPORTATION																						PROJECT MANAGER: D. MUNRO			DRAWN BY: W. GORDON				
																						DESIGNED BY: P. MCKECHNIE			CHECKED BRZEZOWSKI				
																						LUDLOW VT-103 SB 3			SHEET 64 OF 264				