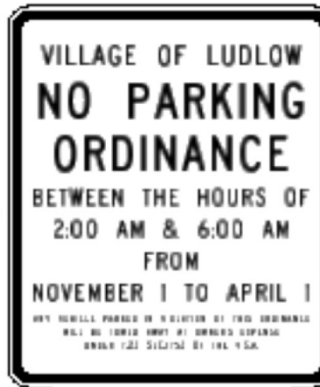
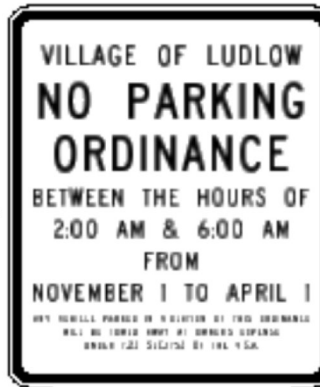
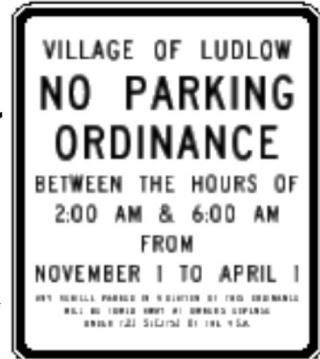
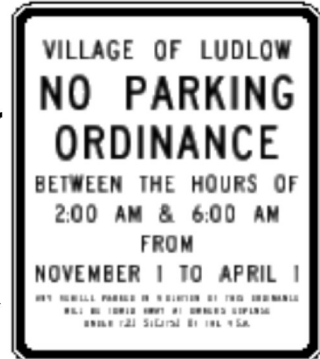


DIRECTION	MILEPOINT	LOCATION CODE (SHEET 4)	SIGN CODE	WIDTH (IN)	HEIGHT (IN)	SHEETING REMARKS	SIGN LEGEND	NEW SIGNS		EXISTING SIGNS				EXIST POST		NUMBER OF NEW POSTS	SQUARE STEEL (IN)			TUBULAR STEEL Ø (IN)				SIGN FRAME REQUIRED	REMARKS	SIGN DETAIL LOCATION			
								"A"	"B"	RETAIN	SALVAGE FROM	SALVAGE TO	REMOVE	RETAIN	REMOVE		1.75	2.00	2.50	FOUNDATION	3.00	3.50	4.00			5.00	SHSM	SIGN DETAILS SHEET #	STANDARD SHEET #
																	(LB / FT)				(LB / FT)								
																	1.88	2.42	3.35		7.60	9.00	10.80			14.60			
SB LUDLOW VT ROUTE 103							FY-FLUORESCENT YELLOW FYG-FLUORESCENT YELLOW GREEN															"SHSM"-STANDARD HIGHWAY SIGNS AND MARKINGS BOOK							
SB	2.211	F	M3-3	24	12				9/1/17	2.00							13'-6" X							INSTALL BEHIND SIDEWALK BETWEEN MAILBOX AND WALKWAY. PROVIDE 7' MINIMUM CLEAR HEIGHT	X				
		F	VM5-1	30	24					5.00													SOUTH, GREEN ON WHITE			E-136			
SB	2.183	G		30	36				9/1/17	7.50							12'-6" X							INSTALL POST IN PLANTER 5' DOWNSTATION FROM UTILITY POLE. PROVIDE 8' MINIMUM CLEAR HEIGHT		3			
		G		12	18					1.50																3			
SB	2.175	F	VD-700										1		X									REMOVE INACCURATE MILE MARKER					
SB	2.165	FE	D3-1					Depot St			1				X									MOUNTED ON UTILITY POLE					
SB	2.134	G		30	36				8/22/17	7.50							14'-9" X							INSTALL POST BEHIND SIDEWALK IN GRASS JUST UPSTATION FROM TOWN INFO BOARD IN LINE WITH UTILITY POLE. PROVIDE 8' MINIMUM CLEAR HEIGHT		3			
		G		12	18					1.50																3			
SB	2.129	F	R2-1																										
		G																						RETURN SIGN TO TOWN					
		F	R2-1	24	30				8/22/17	5.00														INSTALL ON RETAINED POST PROVIDE 7' MINIMUM CLEAR HEIGHT	X				
SB	2.084	G		30	36					7.50							14'-9" X							INSTALL POST BEHIND SIDEWALK, BETWEEN FIRE HYDRANT AND PLANTER. PROVIDE 8' MINIMUM CLEAR HEIGHT		3			
		G		12	18				8/22/17	1.50																3			
																													
SIGN SUMMARY SHEET							SHEET TOTALS		39.00	0.00	1	0	0	3	0	0	4		60.0		0	0.0	0.0	0.0	0.0	PROJECT NAME: STATEWIDE-SOUTH REGION			
									SF	SF	EA	EA	EA	EA	EA	EA		FT		EA	LB	LB	LB	LB	PROJECT NUMBER: STPG SIGN(57)				
																									FILE NAME: z16t041Ludlow 103 SB.xls				
																									PLOT DATE: 2/27/2017				
VERMONT AGENCY OF TRANSPORTATION							TOWN DIRECTIONAL TOTALS		502.1	0.0	48	5	5	120	0	0	62		870.0		2		217.0	DRAWN BY: W. GORDON					
																								CHECKED BRZEZOWSKI					
																							DESIGNED BY: P. MCKECHNIE						
																							LUDLOW VT-103 SB 14						
																							SHEET 75 OF 264						