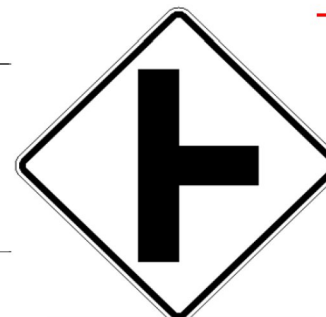


DIRECTION	MILEPOINT	LOCATION CODE (SHEET 4)	SIGN CODE	WIDTH (IN)	HEIGHT (IN)	SHEETING REMARKS	SIGN LEGEND	NEW SIGNS		EXISTING SIGNS				EXIST POST		NUMBER OF NEW POSTS	SQUARE STEEL (IN)			TUBULAR STEEL Ø (IN)				SIGN FRAME REQUIRED	REMARKS	SIGN DETAIL LOCATION			
								"A"	"B"	RETAIN	SALVAGE FROM	SALVAGE TO	REMOVE	RETAIN	REMOVE		1.75	2.00	2.50	FOUNDATION	3.00	3.50	4.00			5.00	SHSM	SIGN DETAILS SHEET #	STANDARD SHEET #
																	(LB / FT)				(LB / FT)								
																	1.88	2.42	3.35		7.60	9.00	10.80			14.60			
SB LUDLOW VT ROUTE 103							FY-FLUORESCENT YELLOW FYG-FLUORESCENT YELLOW GREEN															"SHSM"-STANDARD HIGHWAY SIGNS AND MARKINGS BOOK							
SB	1.171	F	W1-10R				MODIFIED CURVE WARNING						1		X														
		F	W16-8				PREEDOM HILL ROAD						1																
SB	1.141	F	VD-062B				OFFICIAL BUSINESS DIRECTIONAL SIGN			1				X											LaValley's Ludlow Building Supply				
SB	1.104	F	W1-10R	36	36	 8/14/17		9.00								2	14'-9" 14'-6" X							INSTALL SIGN ±350' DOWNSTATION OF EXISTING SIGN AT MP 1.171 SB	X				
		F	W16-8p	36	8			2.00																		5			
SB	1.049	F	W11-6			 8/14/17	SNOWMOBILE CROSSING					1		X															
		F	W11-6	30	30			6.25								1	14'-3" X								FOLDING / HINGED SIGN	X			
SB	1.005	F	W2-2			 8/16/17	T-INTERSECTION SIGN					1		X															
		F	W16-8					PLEASANT STREET EXT.					1																
		F	W2-2	36	36			9.00								2	17'-0" 13'-9" X									X			
		F	W16-8p	36	8			2.00																		5			
SB	0.986	G	VR-017	24	30		 8/16/17	5.00								1	12'-0" X								PLEASANT ST EXT (TH-26) INSTALL NEW SIGN BEHIND GUARDRAIL ON LEGAL LOAD SIDE OF INTERSECTION	X			
SB	0.975	FE	D3-1				Pleasant St Ext			1				X															
		H	R1-1				STOP			1																			
		F	VD-700				MILE MARKER 1030 / 1410 / 0097			1																			
SIGN SUMMARY SHEET						SHEET TOTALS		33.25	0.00	4	0	0	5	0	0	6		90.0	0	0.0	0.0	0.0	0.0	PROJECT NAME: STATEWIDE-SOUTH REGION	PROJECT NUMBER: STPG SIGN(57)			VERMONT AGENCY OF TRANSPORTATION	
								SF	SF	EA	EA	EA	EA	EA	EA	EA		FT		EA	LB	LB	LB	LB					
						TOWN DIRECTIONAL TOTALS		502.1	0.0	48	5	5	120	0	0	62		870.0	2	217.0				FILE NAME: z16t041Ludlow 103 SB.xls				PLOT DATE: 2/27/2017	
																						PROJECT MANAGER: D. MUNRO	DRAWN BY: W. GORDON						
																							DESIGNED BY: P. MCKECHNIE	CHECKED: BRZEZOWSKI					
																							LUDLOW VT-103 SB 19	SHEET 80 OF 264					