
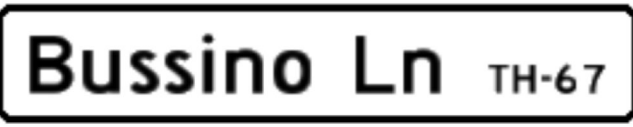






DIRECTION	MILEPOINT	LOCATION CODE (SHEET 4)	SIGN CODE	WIDTH (IN)	HEIGHT (IN)	SHEETING REMARKS	SIGN LEGEND	NEW SIGNS		EXISTING SIGNS			EXIST POST		NUMBER OF NEW POSTS	SQUARE STEEL (IN)			TUBULAR STEEL Ø (IN)				SIGN FRAME REQUIRED	REMARKS	SIGN DETAIL LOCATION									
								"A"	"B"	RETAIN	SALVAGE FROM	SALVAGE TO	REMOVE	RETAIN		REMOVE	1.75	2.00	2.50	FOUNDATION	3.00	3.50			4.00	5.00	SHSM	SIGN DETAILS SHEET #	STANDARD SHEET #					
																	(LB / FT)				(LB / FT)													
NB MOUNT HOLLY VT ROUTE 103							FY-FLUORESCENT YELLOW FYG-FLUORESCENT YELLOW GREEN															"SHSM"-STANDARD HIGHWAY SIGNS AND MARKINGS BOOK												
NB	2.892	AB	D3-1				MARKWELL LN TH58																											
NB	3.429	C	VR-017				 8/16/17																	BUSSINO LN (TH-67)										
		C	VR-017	24	30			5.00															1	12'-3" X			T-70							
NB	3.432	AB	D3-1	60	12		 8/16/17	5.00															2	12'-0" 12'-3" X			7							
NB	3.440	D	R1-1				STOP																											
		C	VD-700				MILE MARKER 1030 / 1112 / 0345				1																							
		D	R1-1	30	30		 8/16/17	6.25																INSTALL ON RETAINED POST	X									
NB	3.564	A	VD-701				 8/22/17																											
		A	VD-701	6	10			0.42															1	8'-0" X			T-42							
NB	3.924	A					 8/23/17																											
		A		24	24			4.00																INSTALL ON RETAINED POST		3								
NB	4.034	A					EMPTY POST																											
							PARKING AREA <---																											
NB	4.039	A					 8/23/17																											
		A		24	18			3.00																INSTALL ON RETAINED POST		3								
		A	M6-1	21	15			2.19																LEFT ARROW, WHITE ON BLUE	X									
SIGN SUMMARY SHEET							SHEET TOTALS	25.85	0.00	1	0	0	6	0	0	4	55.0	0	0.0	0.0	0.0	0.0	PROJECT NAME: STATEWIDE-SOUTH REGION PROJECT NUMBER: STPG SIGN(57)											
							SF	SF	EA	EA	EA	EA	EA	EA	EA	EA	FT	EA	LB	LB	LB	LB	FILE NAME: z16t041Mt Holliv103 NB.xls PROJECT MANAGER: D. MUNRO DESIGNED BY: P. MCKECHNIE MOUNT HOLLY VT-103 NB 5						PLOT DATE: 2/27/2017 DRAWN BY: W. GORDON CHECKED: BRZEZOWSK SHEET 87 OF 264					
VERMONT AGENCY OF TRANSPORTATION							TOWN DIRECTIONAL TOTALS	349.8	0.0	22	7	7	78	0	0	48	680.0	0		0.0														