




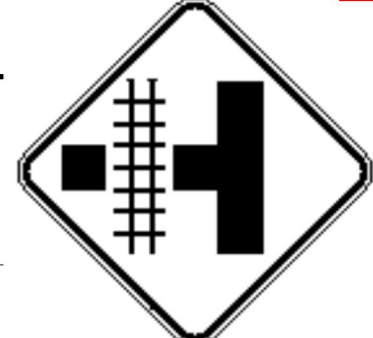

DIRECTION	MILEPOINT	LOCATION CODE (SHEET 4)	SIGN CODE	WIDTH (IN)	HEIGHT (IN)	SHEETING REMARKS	SIGN LEGEND	NEW SIGNS		EXISTING SIGNS			EXIST POST		NUMBER OF NEW POSTS	SQUARE STEEL (IN)			TUBULAR STEEL Ø (IN)				SIGN FRAME REQUIRED	REMARKS	SIGN DETAIL LOCATION				
								"A"	"B"	RETAIN	SALVAGE FROM	SALVAGE TO	REMOVE	RETAIN		REMOVE	1.75	2.00	2.50	FOUNDATION	3.00	3.50			4.00	5.00	SHSM	SIGN DETAILS SHEET #	STANDARD SHEET #
																	(LB / FT)				(LB / FT)								
NB MOUNT HOLLY VT ROUTE 103							FY-FLUORESCENT YELLOW FYG-FLUORESCENT YELLOW GREEN															"SHSM"-STANDARD HIGHWAY SIGNS AND MARKINGS BOOK							
NB	4.119	A	W10-3				 T INTERSECTION RAILROAD CROSSING <i>8/23/17</i>																						
NB	4.150	A	W10-3	36	36																		INSTALL ±165 FT NORTH OF EXISTING SIGN AT MP 4.119 NB	X					
		A	W16-8p	24	8			1.33														INSTALL ON LEFT POST		5					
NB	4.230	C	VR-017				 LEGAL LOAD LIMIT 24,000 POUNDS <i>8/17/17</i>															OLD TURNPIKE RD (TH-4)							
		C	VR-017	24	30				5.00														INSTALL ON RETAINED POST			T-70			
NB	4.230	AB	D3-1	68	12		 Old Turnpike Rd TH-4 <i>8/17/17</i>	5.67														INSTALL INDEPENDENTLY ON TWO POSTS ON LEGAL LOAD SIDE OF THE INTERSECTION		7					
NB	4.244	D					OLD TURNPIKE ROAD TH																						
NB	4.244	D	R1-1				STOP																						
		C	VD-700				 MILE MARKER 1030 / 1112 / 0425 <i>8/17/17</i>																						
		D	R1-1	30	30				6.25															X					
		C	VD-700				MILE MARKER 1030 / 1112 / 0425															INSTALL BACK TO BACK ON STOP SIGN POST							
NB	4.965	A	VD-062B				OFFICIAL BUSINESS DIRECTIONAL SIGN															Village Baptist Church							
SIGN SUMMARY SHEET							SHEET TOTALS	27.25	0.00	1	1	1	5	0	0	5	75.0	0	0.0	0.0	0.0	0.0	PROJECT NAME: STATEWIDE-SOUTH REGION PROJECT NUMBER: STPG SIGN(57)						
VERMONT AGENCY OF TRANSPORTATION							TOWN DIRECTIONAL TOTALS	349.8	0.0	22	7	7	78	0	0	48	680.0	0		0.0				FILE NAME: z16t041Mt Holliv103 NB.xls PROJECT MANAGER: D. MUNRO DESIGNED BY: P. MCKECHNIE MOUNT HOLLY VT-103 NB 6	PLOT DATE: 2/27/2017 DRAWN BY: W. GORDON CHECKED: BRZEZOWSK SHEET 88 OF 264				