
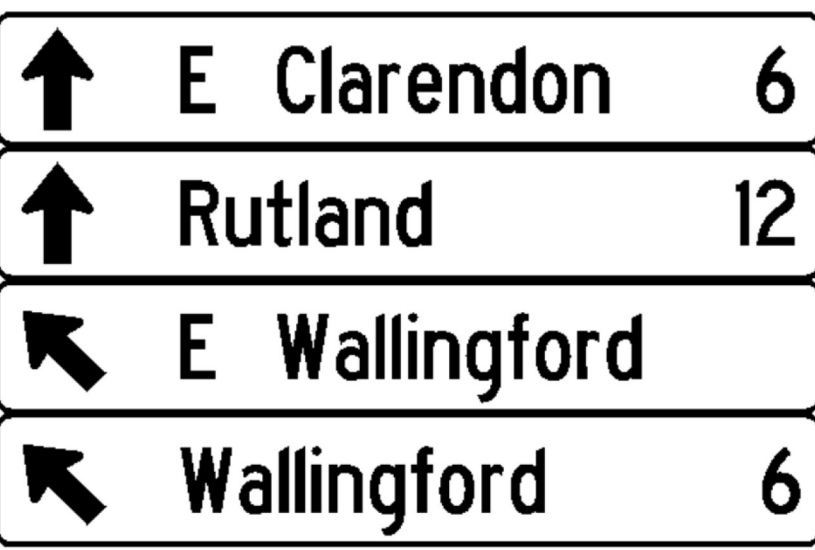



DIRECTION	MILEPOINT	LOCATION CODE (SHEET 4)	SIGN CODE	WIDTH (IN)	HEIGHT (IN)	SHEETING REMARKS	SIGN LEGEND	NEW SIGNS		EXISTING SIGNS			EXIST POST		NUMBER OF NEW POSTS	SQUARE STEEL (IN)			TUBULAR STEEL Ø (IN)				SIGN FRAME REQUIRED	REMARKS	SIGN DETAIL LOCATION				
								"A"	"B"	RETAIN	SALVAGE FROM	SALVAGE TO	REMOVE	RETAIN		REMOVE	1.75	2.00	2.50	FOUNDATION	3.00	3.50			4.00	5.00	SHSM	SIGN DETAILS SHEET #	STANDARD SHEET #
																	(LB / FT)				(LB / FT)								
<b>NB MOUNT HOLLY VT ROUTE 103</b>							FY-FLUORESCENT YELLOW FYG-FLUORESCENT YELLOW GREEN															"SHSM"-STANDARD HIGHWAY SIGNS AND MARKINGS BOOK							
NB	7.394	A	M2-1				 8/24/17																						
		A	VM1-5																										
		A	M2-1	21	15																		INSTALL ON RETAINED POST JCT, GREEN ON WHITE	X					
		A	VM1-5	30	24																					E-136			
NB	7.455	A	VD1-1A				(UP) E. CLARENDON 6																						
		A	VD1-1A				(UP) RUTLAND 14																						
		A	VD1-1				(UP AND LEFT) E. WALLINGFORD																						
		A	VD1-1A				(UP AND LEFT) WALLINGFORD 6																						
		A	VD1-1A	72	12		 12/1/17																						
		A	VD1-1A	72	12																								
		A	VD1-1	72	12																								
		A	VD1-1A	72	12																								
NB	7.490	C	VR-017				 8/17/17																						
		C	VR-017	24	30																		ROGER HILL RD (TH-10)						
																						INSTALL ON RETAINED POST			T-70				
NB	7.490	AB	D3-1				ROGER HILL RD TH-10																						
<b>SIGN SUMMARY SHEET</b>							<b>SHEET TOTALS</b>	36.19	0.00	3	0	0	5	0	0	2	30.0	0	0.0	0.0	0.0	0.0	PROJECT NAME: STATEWIDE-SOUTH REGION PROJECT NUMBER: STPG SIGN(57)						
VERMONT AGENCY OF TRANSPORTATION							<b>TOWN DIRECTIONAL TOTALS</b>	349.8	0.0	22	7	7	78	0	0	48	680.0	0		0.0			FILE NAME: z16t041Mt Hollv103 NB.xls PROJECT MANAGER: D. MUNRO DESIGNED BY: P. MCKECHNIE MOUNT HOLLY VT-103 NB 11	PLOT DATE: 2/27/2017 DRAWN BY: W. GORDON CHECKED: BRZEZOWSK SHEET 93 OF 264					