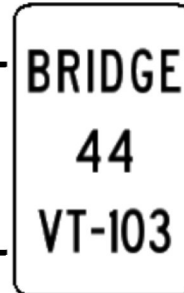


DIRECTION	MILEPOINT	LOCATION CODE (SHEET 4)	SIGN CODE	WIDTH (IN)	HEIGHT (IN)	SHEETING REMARKS	SIGN LEGEND	NEW SIGNS		EXISTING SIGNS				EXIST POST		NUMBER OF NEW POSTS	SQUARE STEEL (IN)			TUBULAR STEEL Ø (IN)				SIGN FRAME REQUIRED	REMARKS	SIGN DETAIL LOCATION						
								"A"	"B"	RETAIN	SALVAGE FROM	SALVAGE TO	REMOVE	RETAIN	REMOVE		1.75	2.00	2.50	FOUNDATION	3.00	3.50	4.00			5.00	SHSM	SIGN DETAILS SHEET #	STANDARD SHEET #			
																	(LB / FT)				(LB / FT)											
																	1.88	2.42	3.35		7.60	9.00	10.80			14.60						
SB MOUNT HOLLY VT 103							FY-FLUORESCENT YELLOW FYG-FLUORESCENT YELLOW GREEN															"SHSM"-STANDARD HIGHWAY SIGNS AND MARKINGS BOOK										
SB	7.624	F	M2-1				JCT						1	X																		
		F	VM1-5				VERMONT 140						1																			
		F	VD-701				BRIDGE / 44 / VT 103						1																			
		F	M2-1	21	15		 8/25/17	2.19																INSTALL ON RETAINED POST JCT, GREEN ON WHITE	X							
		F	VM1-5	30	24		 8/25/17	5.00																				E-136				
SB	7.619	F	VD-701	6	10			0.42							1	8'-6" X												T-42				
SB	7.589	F	VD1-1A				(UP) MOUNT HOLLY 2						1	X																		
		F	VD1-1A				(UP) LUDLOW 11						1																			
		F	VD1-1A	72	12		 8/25/17	6.00																INSTALL ON RETAINED POSTS				T-93				
		F	VD1-1A	72	12		 8/25/17	6.00																				T-93				
SB	7.554	F	M3-3				SOUTH						1	X																		
		F	VM1-5				VERMONT 103						1																			
		F	M6-3				UP ARROW						1																			
		F	M3-4				WEST						1																			
		F	VM1-5				VERMONT 140						1																			
SIGN SUMMARY SHEET							SHEET TOTALS	19.60	0.00	0	0	0	10	0	0	1	10.0			0	0.0	0.0	0.0	0.0	PROJECT NAME: STATEWIDE-SOUTH REGION	PROJECT NUMBER: STPG SIGN(57)			VERMONT AGENCY OF TRANSPORTATION			
								SF	SF	EA	EA	EA	EA	EA	EA	EA		FT		EA	LB	LB	LB	LB								
																															FILE NAME: z16t041Mt Hollv103 SB.xls	PLOT DATE: 2/27/2017
							TOWN DIRECTIONAL TOTALS							367.7	0.0	11	4	5	82	0	0	41	585.0			0	0.0				PROJECT MANAGER: D. MUNRO	DRAWN BY: W. GORDON
																								DESIGNED BY: P. MCKECHNIE	CHECKED: BRZEZOWSKI							
																								MOUNT HOLLY VT-103 SB 1	SHEET 97 OF 264							