

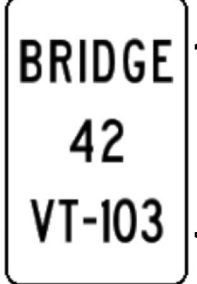


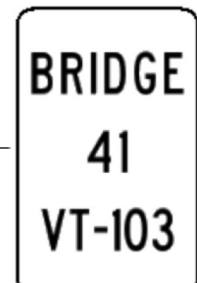
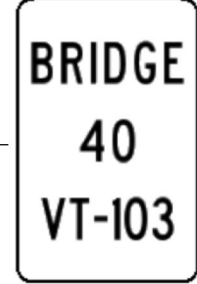


DIRECTION	MILEPOINT	LOCATION CODE (SHEET 4)	SIGN CODE	WIDTH (IN)	HEIGHT (IN)	SHEETING REMARKS	SIGN LEGEND	NEW SIGNS		EXISTING SIGNS			EXIST POST		NUMBER OF NEW POSTS	SQUARE STEEL (IN)			TUBULAR STEEL Ø (IN)				SIGN FRAME REQUIRED	REMARKS	SIGN DETAIL LOCATION				
								"A"	"B"	RETAIN	SALVAGE FROM	SALVAGE TO	REMOVE	RETAIN		REMOVE	1.75	2.00	2.50	FOUNDATION	3.00	3.50			4.00	5.00	SHSM	SIGN DETAILS SHEET #	STANDARD SHEET #
																	(LB / FT)				(LB / FT)								
<b>SB MOUNT HOLLY VT 103</b>							FY-FLUORESCENT YELLOW FYG-FLUORESCENT YELLOW GREEN															"SHSM"-STANDARD HIGHWAY SIGNS AND MARKINGS BOOK							
		E	W1-6R	48	24		 8/22/17	8.00							2	12'-0" 12'-0" X							INSTALL ±10 FT DOWN STATION OF EXISTING SIGN AT MP 6.482 NB	X					
SB	6.169	E	W5-2				 8/22/17																						
		E	VW-619	30	30			NARROW BRIDGE					1	X										INSTALL ON RETAINED POST			T-82		
SB	6.025	F	VD-701	6	10		 9/7/17	0.42							1	8'-3" X									T-42				
SB	6.024	F	OM3-R					TYPE 3 OBJECT MARKER																					
		F	VD-701				 9/7/17																						
		F	OM3-R	12	36			BRIDGE / 42 / VT103																					
SB	6.014	E	OM3-L	12	36			 9/7/17	3.00							1	10'-6" X							X					
SB	5.904	F	VD-701				 8/23/17																						
		F	VD-701	6	10			BRIDGE 41 VT-103	0.42															INSTALL ON RETAINED POST		T-42			
SB	5.464	F	VD-701				 8/23/17																						
		F	VD-701	6	10			BRIDGE 40 VT-103	0.42															INSTALL ON RETAINED POST		T-42			
SB	5.424	F	VD-062B				OFFICIAL BUSINESS DIRECTIONAL SIGN			1															Village Baptist Church				
SB	5.384	F	W11-8				EMERGENCY VEHICLE																		REMOVE LEFT POST RETAIN RIGHT POST				
		F	VD-700				MILE MARKER 1030 / 1112 / 0540				1																		
<b>SIGN SUMMARY SHEET</b>							<b>SHEET TOTALS</b>	21.50	0.00	1	1	0	7	0	0	5	70.0	0	0.0	0.0	0.0	0.0		PROJECT NAME: STATEWIDE-SOUTH REGION					
								SF	SF	EA	EA	EA	EA	EA	EA	EA	FT	EA	LB	LB	LB	LB		PROJECT NUMBER: STPG SIGN(57)					
VERMONT AGENCY OF TRANSPORTATION							<b>TOWN DIRECTIONAL TOTALS</b>	367.7	0.0	11	4	5	82	0	0	41	585.0	0		0.0				FILE NAME: z16t041Mt Holliv103 SB.xls	PLOT DATE: 2/27/2017				
																							PROJECT MANAGER: D. MUNRO	DRAWN BY: W. GORDON					
																							DESIGNED BY: P. MCKECHNIE	CHECKED: BRZEZOWSK					
																							MOUNT HOLLY VT-103 SB 4	SHEET 100 OF 264					