
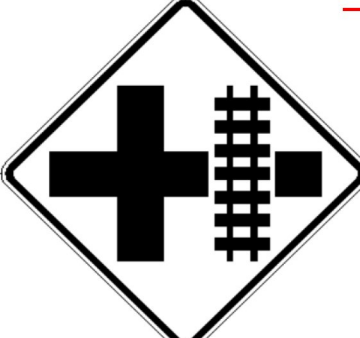








DIRECTION	MILEPOINT	LOCATION CODE (SHEET 4)	SIGN CODE	WIDTH (IN)	HEIGHT (IN)	SHEETING REMARKS	SIGN LEGEND	NEW SIGNS		EXISTING SIGNS			EXIST POST		NUMBER OF NEW POSTS	SQUARE STEEL (IN)			TUBULAR STEEL Ø (IN)				SIGN FRAME REQUIRED	REMARKS	SIGN DETAIL LOCATION				
								"A"	"B"	RETAIN	SALVAGE FROM	SALVAGE TO	REMOVE	RETAIN		REMOVE	1.75	2.00	2.50	FOUNDATION	3.00	3.50			4.00	5.00	SHSM	SIGN DETAILS SHEET #	STANDARD SHEET #
																	(LB / FT)				(LB / FT)								
SB MOUNT HOLLY VT 103							FY-FLUORESCENT YELLOW FYG-FLUORESCENT YELLOW GREEN															"SHSM"-STANDARD HIGHWAY SIGNS AND MARKINGS BOOK							
		F	W11-8	30	30			9/7/17	6.25														INSTALL ON RETAINED RIGHT POST	X					
		F	VD-700				MILE MARKER 1030 / 1112 / 0540				1															T-44			
SB	5.346	A	W10-2	36	36			4/9/18	9.00						2	X							INSTALL 200 FT ± SOUTH OF EXISTING SIGN AT MP 5.384 SB	X					
		A	W16-8aP	51	15				5.31																5				
SB	5.297	F	VD2-1S				MOUNT HOLLY --> SCHOOL					1																	
		F	VD1-1A				BELMONT 2 -->					1																	
		F	VD1-1A				<-- HORTONVILLE 2					1																	
SB	5.289	F	VD2-1S	72	20			9/7/17	10.00						2		16'-6" 14'-6" X						INSTALL SIGN BEHIND GUARDRAIL, 40' DOWNSTATION FROM EXISTING SIGN AT MP 5.297 SB			T-93			
		F	VD1-1A	72	12				6.00																	T-93			
		F	VD1-1A	72	12				6.00																	T-93			
SB	5.269	G	W10-1					4/9/18																					
		G	VR-017					8/18/17				1											BELMONT RD (TH-1)						
		G	VR-017	24	30				5.00						1		13'-9" X					INSTALL NEW SIGN AT SAME LOCATION ON BELMONT RD			T-70				
SB	5.251	H	R1-1				STOP					1			X	X													
		G	VD-700				MILE MARKER 1030 / 1112 / 0528				1																		
SIGN SUMMARY SHEET							SHEET TOTALS		47.56	0.00	1	0	1	6	0	0	5	75.0	0	0.0	0.0	0.0	0.0	PROJECT NAME: STATEWIDE-SOUTH REGION PROJECT NUMBER: STPG SIGN(57)					
								SF	SF		EA	EA	EA	EA	EA	EA	EA	FT	EA	LB	LB	LB	LB	FILE NAME: z16t041Mt Hollv103 SB.xls PROJECT MANAGER: D. MUNRO					
VERMONT AGENCY OF TRANSPORTATION							TOWN DIRECTIONAL TOTALS		367.7	0.0	11	4	5	82	0	0	41	585.0	0		0.0			DESIGNED BY: P. MCKECHNIE MOUNT HOLLY VT-103 SB 5					
																								PLOT DATE: 2/27/2017 DRAWN BY: W. GORDON CHECKED: BRZEZOWSK SHEET 101 OF 264					