
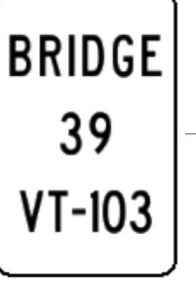


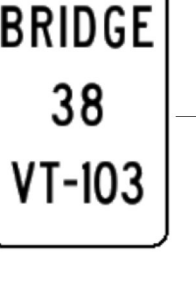
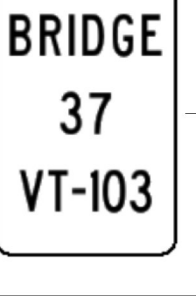


DIRECTION	MILEPOINT	LOCATION CODE (SHEET 4)	SIGN CODE	WIDTH (IN)	HEIGHT (IN)	SHEETING REMARKS	SIGN LEGEND	NEW SIGNS		EXISTING SIGNS			EXIST POST		NUMBER OF NEW POSTS	SQUARE STEEL (IN)			TUBULAR STEEL Ø (IN)				SIGN FRAME REQUIRED	REMARKS	SIGN DETAIL LOCATION				
								"A"	"B"	RETAIN	SALVAGE FROM	SALVAGE TO	REMOVE	RETAIN		REMOVE	1.75	2.00	2.50	FOUNDATION	3.00	3.50			4.00	5.00	SHSM	SIGN DETAILS SHEET #	STANDARD SHEET #
																	(LB / FT)				(LB / FT)								
SB MOUNT HOLLY VT 103							FY-FLUORESCENT YELLOW FYG-FLUORESCENT YELLOW GREEN															"SHSM"-STANDARD HIGHWAY SIGNS AND MARKINGS BOOK							
		H	R1-1	30	30			6.25															INSTALL ON RETAINED POST	X					
SB	5.244	EF	D3-1				Belmont Rd TH1			1			X																
SB	5.243	G	W10-1				GRADE CROSSING ADVANCE WARNING							1		X													
SB	5.239	F	VD-701				 4/9/18	0.42						1		X								INSTALL ON RETAINED POST			T-42		
SB	5.229	F	M3-3				 8/22/17						1		X														
		F	VM1-5											1										INSTALL ON RETAINED POST					
		F	M3-3	24	12			2.00																SOUTH, GREEN ON WHITE	X				
		F	VM1-5	30	24			5.00																			E-136		
SB	5.184	F	R2-1				 8/22/17						1		X														
		F	R2-1	24	30			5.00																INSTALL ON RETAINED POST	X				
SB	5.109	F	VD-701				 8/22/17							1		X													
		F	VD-701	6	10			0.42																INSTALL ON RETAINED POST			T-42		
SB	4.639	F	VD-701				 8/22/17							1		X													
		F	VD-701	6	10			0.42																INSTALL ON RETAINED POST			T-42		
SIGN SUMMARY SHEET							SHEET TOTALS	19.50	0.00	1	0	0	7	0	0	1	15.0	0	0.0	0.0	0.0	0.0		PROJECT NAME: STATEWIDE-SOUTH REGION					
							SF SF			EA	EA	EA	EA	EA	EA	EA	FT	EA	LB	LB	LB	LB		PROJECT NUMBER: STPG SIGN(57)					
VERMONT AGENCY OF TRANSPORTATION							TOWN DIRECTIONAL TOTALS	367.7	0.0	11	4	5	82	0	0	41	585.0	0		0.0					FILE NAME: z16t041Mt Holliv103 SB.xls	PLOT DATE: 2/27/2017			
																									PROJECT MANAGER: D. MUNRO	DRAWN BY: W. GORDON			
																										DESIGNED BY: P. MCKECHNIE	CHECKED: BRZEZOWSK		
																										MOUNT HOLLY VT-103 SB 6	SHEET 102 OF 264		