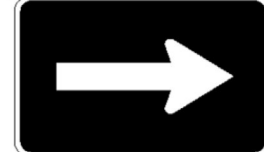


DIRECTION	MILEPOINT	LOCATION CODE (SHEET 4)	SIGN CODE	WIDTH (IN)	HEIGHT (IN)	SHEETING REMARKS	SIGN LEGEND	NEW SIGNS		EXISTING SIGNS				EXIST POST		NUMBER OF NEW POSTS	SQUARE STEEL (IN)			TUBULAR STEEL Ø (IN)				SIGN FRAME REQUIRED	REMARKS	SIGN DETAIL LOCATION				
								"A"	"B"	RETAIN	SALVAGE FROM	SALVAGE TO	REMOVE	RETAIN	REMOVE		1.75	2.00	2.50	FOUNDATION	3.00	3.50	4.00			5.00	SHSM	SIGN DETAILS SHEET #	STANDARD SHEET #	
																	(LB / FT)				(LB / FT)									
																	1.88	2.42	3.35		7.60	9.00	10.80			14.60				
SB MOUNT HOLLY VT 103							FY-FLUORESCENT YELLOW FYG-FLUORESCENT YELLOW GREEN															"SHSM"-STANDARD HIGHWAY SIGNS AND MARKINGS BOOK								
SB	4.299	F	W10-3R				 HIGHWAY-RAIL GRADE CROSSING ADVANCE WARNING 8/22/17						1		X															
		F	W10-3R	36	36			9.00										15'-3" 14'-9" X								X				
		F	W16-8p	24	8		 Summit Rd 8/22/17	1.33																	INSTALL ON RIGHT POST		5			
SB	4.254	F					 PARKING AREA AHEAD 8/22/17						1	X																
		F		24	24			4.00																			3			
SB	4.209	G	VR-017				 LEGAL LOAD LIMIT 24,000 POUNDS 8/15/17						1	X																
		G	VR-017	24	30			5.00																				T-70		
SB	4.209	EF	D3-1	64	12		 Summit Rd TH-42 8/15/17	5.33									2		15'-3" 14'-9" X								INSTALL INDEPENDENTLY ON TWO POSTS ON LEGAL LOAD SIDE OF THE INTERSECTION		7	
SB	4.194	H	R1-1										1		X															
		G	VD-700									1		1																
		H	R1-1	30	30		 STOP 8/15/17	6.25									1		12'-9" X								X			
		G	VD-700									1													INSTALL BACK TO BACK ON STOP SIGN POST					
SB	4.193	EF	D3-1											1		X														
SB	4.164	F					 PARKING AREA 8/22/17							1	X															
		F		24	18		 8/22/17	3.00																		INSTALL ON RETAINED POST		3		
SIGN SUMMARY SHEET							SHEET TOTALS		33.92	0.00	0	1	1	7	0	0	5	75.0			0	0.0	0.0	0.0	0.0	PROJECT NAME: STATEWIDE-SOUTH REGION				
									SF	SF	EA	EA	EA	EA	EA	EA	EA	FT			EA	LB	LB	LB	LB	PROJECT NUMBER: STPG SIGN(57)				
																									FILE NAME: z16t041Mt Holly103 SB.xls					
																									PROJECT MANAGER: D. MUNRO					
VERMONT AGENCY OF TRANSPORTATION							TOWN DIRECTIONAL TOTALS		367.7	0.0	11	4	5	82	0	0	41	585.0			0	0.0				DESIGNED BY: P. MCKECHNIE				
																								MOUNT HOLLY VT-103 SB 7						
																								PLOT DATE: 2/27/2017						
																								DRAWN BY: W. GORDON						
																								CHECKED: BRZEZOWSKI						
																								SHEET 103 OF 264						