


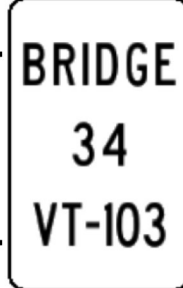





DIRECTION	MILEPOINT	LOCATION CODE (SHEET 4)	SIGN CODE	WIDTH (IN)	HEIGHT (IN)	SHEETING REMARKS	SIGN LEGEND	NEW SIGNS		EXISTING SIGNS			EXIST POST	NUMBER OF NEW POSTS	SQUARE STEEL (IN)			TUBULAR STEEL Ø (IN)				SIGN FRAME REQUIRED	REMARKS	SIGN DETAIL LOCATION					
								"A"	"B"	RETAIN	SALVAGE FROM	SALVAGE TO	REMOVE		RETAIN	REMOVE	1.75	2.00	2.50	FOUNDATION	3.00			3.50	4.00	5.00	SHSM	SIGN DETAILS SHEET #	STANDARD SHEET #
																	(LB / FT)				(LB / FT)								
SB MOUNT HOLLY VT 103							FY-FLUORESCENT YELLOW FYG-FLUORESCENT YELLOW GREEN														"SHSM"-STANDARD HIGHWAY SIGNS AND MARKINGS BOOK								
SB	1.594	G	VR-017				 9/5/17					1	X								HEALDVILLE RD (TH-2)								
		G	VR-017	24	30			5.00													INSTALL ON RETAINED POST			T-70					
SB	1.578	EF	D3-1				HEALDVILLE RD					1		X															
		EF	D3-1	68	12		 9/5/17	5.67						2	12'-9" 11'-9" X						INSTALL INDEPENDENTLY ON TWO POSTS ON STOP SIGN SIDE OF THE INTERSECTION		7						
SB	1.577	H	R1-1				STOP					1	X																
		G	VD-700				MILE MARKER 1030 / 1112 / 0161			1																			
		G	VD-701				BRIDGE / 34 / VT 103					1									INSTALL ON RETAINED POST								
		H	R1-1	30	30		 9/5/17	6.25														X							
SB	1.577	F	VD-701	6	10		 9/5/17	0.42						1	7'-6" X									T-42					
SB	1.554	G	VR-017				 8/14/17					1	X								GREENSTAND RD (TH-43)								
		G	VR-017	24	30			5.00													INSTALL ON RETAINED POST			T-70					
SB	1.554	EF	D3-1	72	12		 8/14/17	6.00						2	13'-6" 13'-0" X						INSTALL INDEPENDENTLY ON TWO POSTS ON LEGAL LOAD SIDE OF THE INTERSECTION		7						
SB	1.544	H	R1-1	30	30		8/15/17 	6.25						1	13'-3" X						INSTALL NEW SIGN ON STOP SIGN SIDE OF THE INTERSECTION	X							
SB	1.529	F	M3-3				SOUTH					1	X																
		F	VM1-5				VERMONT 103					1																	
SIGN SUMMARY SHEET							SHEET TOTALS	34.58	0.00	1	0	0	7	0	0	6	85.0	0	0.0	0.0	0.0	0.0	PROJECT NAME: STATEWIDE-SOUTH REGION PROJECT NUMBER: STPG SIGN(57)						
								SF	SF	EA	EA	EA	EA	EA	EA	EA	FT	EA	LB	LB	LB	LB	FILE NAME: z16t041Mt Holly103 SB.xls PROJECT MANAGER: D. MUNRO DESIGNED BY: P. MCKECHNIE MOUNT HOLLY VT-103 SB 10	PLOT DATE: 2/27/2017 DRAWN BY: W. GORDON CHECKED: BRZEZOWSKA SHEET 106 OF 264					
VERMONT AGENCY OF TRANSPORTATION							TOWN DIRECTIONAL TOTALS	367.7	0.0	11	4	5	82	0	0	41	585.0	0		0.0									