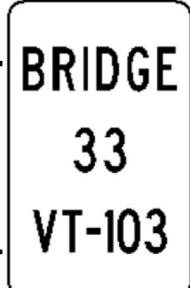


DIRECTION	MILEPOINT	LOCATION CODE (SHEET 4)	SIGN CODE	WIDTH (IN)	HEIGHT (IN)	SHEETING REMARKS	SIGN LEGEND	NEW SIGNS		EXISTING SIGNS				EXIST POST		NUMBER OF NEW POSTS	SQUARE STEEL (IN)			TUBULAR STEEL Ø (IN)				SIGN FRAME REQUIRED	REMARKS	SIGN DETAIL LOCATION			
								"A"	"B"	RETAIN	SALVAGE FROM	SALVAGE TO	REMOVE	RETAIN	REMOVE		1.75	2.00	2.50	FOUNDATION	3.00	3.50	4.00			5.00	SHSM	SIGN DETAILS SHEET #	STANDARD SHEET #
																	(LB / FT)				(LB / FT)								
																	1.88	2.42	3.35		7.60	9.00	10.80			14.60			
SB MOUNT HOLLY VT 103							FY-FLUORESCENT YELLOW FYG-FLUORESCENT YELLOW GREEN															"SHSM"-STANDARD HIGHWAY SIGNS AND MARKINGS BOOK							
		F	M3-3	24	12		 8/18/17	2.00															INSTALL ON RETAINED POST						
		F	VM1-5	24	24			4.00															SOUTH, GREEN ON WHITE	X		E-136			
SB	1.494	F	R2-1				 8/18/17					1	X																
		F	R2-1	24	30			5.00															INSTALL ON RETAINED POSTS	X					
SB	1.129	EF	D3-1				 GREENSTAND RD			1			X										GREENSTAND RD (TH-43)						
SB	1.129	G	VR-017	24	30		 8/14/17	5.00						1		13'-6" X							INSTALL NEW SIGN ON LEGAL LOAD SIDE OF INTERSECTION			T-70			
SB	1.119	H	R1-1				STOP					1	X																
		G	VD-700				MILE MARKER 1030 / 1112 / 0114			1																			
		H	R1-1	30	30		 8/14/17	6.25															INSTALL ON RETAINED POST	X					
SB	1.050	F	VD-701	6	10		 9/2/17	0.42						1		7'-3" X										T-42			
SB	1.049	F	OM3-R				RIGHT OBJECT MARKER					1		X															
		F	VD-701				BRIDGE / 33 / VT103					1																	
		F	OM3-R	12	36		 9/7/17	3.00						1		10'-9" X									X				
SB	1.029	E	OM3-L				 9/7/17					1		X															
		E	OM3-L	12	36			3.00						1		10'-6" X									X				
SIGN SUMMARY SHEET							SHEET TOTALS	28.67	0.00	2	0	0	5	0	0	4	55.0	0	0.0	0.0	0.0	0.0	PROJECT NAME: STATEWIDE-SOUTH REGION	PROJECT NUMBER: STPG SIGN(57)					
								SF	SF	EA	EA	EA	EA	EA	EA	EA	FT	EA	LB	LB	LB	LB	FILE NAME: z16t041Mt Holly103 SB.xls	PLOT DATE: 2/27/2017					
							TOWN DIRECTIONAL TOTALS	367.7	0.0	11	4	5	82	0	0	41	585.0	0	0.0				DESIGNED BY: P. MCKECHNIE	CHECKED: W. GORDON					
VERMONT AGENCY OF TRANSPORTATION																							DESIGNED BY: P. MCKECHNIE	MOUNT HOLLY VT-103 SB 11					
																								SHEET 107 OF 264					