


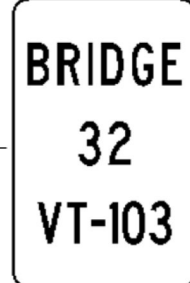




DIRECTION	MILEPOINT	LOCATION CODE (SHEET 4)	SIGN CODE	WIDTH (IN)	HEIGHT (IN)	SHEETING REMARKS	SIGN LEGEND	NEW SIGNS		EXISTING SIGNS			EXIST POST		NUMBER OF NEW POSTS	SQUARE STEEL (IN)			TUBULAR STEEL Ø (IN)				SIGN FRAME REQUIRED	REMARKS	SIGN DETAIL LOCATION				
								"A"	"B"	RETAIN	SALVAGE FROM	SALVAGE TO	REMOVE	RETAIN		REMOVE	1.75	2.00	2.50	FOUNDATION	3.00	3.50			4.00	5.00	SHSM	SIGN DETAILS SHEET #	STANDARD SHEET #
																	(LB / FT)				(LB / FT)								
SB MOUNT HOLLY VT 103							FY-FLUORESCENT YELLOW FYG-FLUORESCENT YELLOW GREEN															"SHSM"-STANDARD HIGHWAY SIGNS AND MARKINGS BOOK							
SB	1.009	G	VR-017				LLL 24,000 LBS					1	X									STATION RD (TH-47)							
		G					NO THRU TRAFFIC					1										INSTALL ON RETAINED POST			T-70				
		G	VR-017	24	30		 8/14/17					5.00																	
SB	1.009	EF	D3-1	60	12		8/14/17 								2								INSTALL INDEPENDENTLY ON TWO POSTS ON LEGAL LOAD SIDE OF THE INTERSECTION		7				
SB	0.999	H	R1-1				STOP					1	X																
		G	VD-700				MILE MARKER 1030 / 1112 / 0102			1																			
		H	R1-1	30	30		 8/14/17					6.25										INSTALL ON RETAINED POST	X						
SB	0.998	EF					STATION ROAD 47					1	X																
SB	0.804	F	VD-701				 8/21/17					1	X									INSTALL ON RETAINED POST			T-42				
		F	VD-701	6	10							0.42																	
SB	0.770	F	VW-050				BEAR CROSSING					1	X																
		F	W7-3aP				NEXT 2 MILES					1																	
		F	VW-050	30	30		 8/18/17					6.25													2				
		F	W11-16	24	18							3.00											X						
SIGN SUMMARY SHEET							SHEET TOTALS	25.92	0.00	1	0	0	7	0	0	3	45.0	0	0.0	0.0	0.0	0.0	PROJECT NAME: STATEWIDE-SOUTH REGION PROJECT NUMBER: STPG SIGN(57)						
VERMONT AGENCY OF TRANSPORTATION							TOWN DIRECTIONAL TOTALS	367.7	0.0	11	4	5	82	0	0	41	585.0	0		0.0		FILE NAME: z16t041Mt Holliv103 SB.xls PROJECT MANAGER: D. MUNRO DESIGNED BY: P. MCKECHNIE MOUNT HOLLY VT-103 SB 12	PLOT DATE: 2/27/2017 DRAWN BY: W. GORDON CHECKED: BRZEZOWSK SHEET 108 OF 264						