




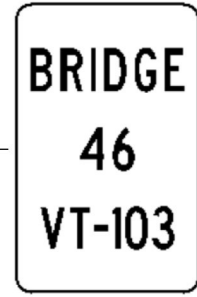


DIRECTION	MILEPOINT	LOCATION CODE (SHEET 4)	SIGN CODE	WIDTH (IN)	HEIGHT (IN)	SHEETING REMARKS	SIGN LEGEND	NEW SIGNS		EXISTING SIGNS			EXIST POST		NUMBER OF NEW POSTS	SQUARE STEEL (IN)			TUBULAR STEEL Ø (IN)				SIGN FRAME REQUIRED	REMARKS	SIGN DETAIL LOCATION								
								"A"	"B"	RETAIN	SALVAGE FROM	SALVAGE TO	REMOVE	RETAIN		REMOVE	1.75	2.00	2.50	FOUNDATION	3.00	3.50			4.00	5.00	SHSM	SIGN DETAILS SHEET #	STANDARD SHEET #				
																	(LB / FT)				(LB / FT)												
NB WALLINGFORD VT RTE 103							FY-FLUORESCENT YELLOW FYG-FLUORESCENT YELLOW GREEN															"SHSM"-STANDARD HIGHWAY SIGNS AND MARKINGS BOOK											
NB	0.301	A	VD-701				 9/11/17					1	X									INSTALL ON RETAINED POST			T-42								
		A	VD-701	6	10			0.42																									
NB	0.317	A	R2-1	24	30		 9/11/17								1					12'-3" X				INSTALL ±85 FT UPSTATION OF EXISTING SIGN AT MP 0.301 NB	X								
NB	0.320						EMPTY POST															REMOVE POST STUB. PAID FOR AS ITEM 675.12, REMOVING DELINEATORS.											
NB	0.340	A	VW-133R	30	30		 9/11/17								1					12'-6" X						T-81							
NB	0.366	A	VW-619				 9/11/17					1	X	X								REMOVE LEFT POST RETAIN RIGHT POST											
		A	VW-619	30	30			6.25														INSTALL ON RETAINED POST			T-82								
NB	0.391	A	D3-1							1			X																				
NB	0.481	A	VD2-1							1			X																				
NB	0.846	A	W8-1							1			X									SEASONAL SIGN											
NB	1.036																					REMOVE FLASHING BEACON AND ELECTRIC POWER METER AFTER DISCONNECTING FROM THE POWER SOURCE. PAYMENT WILL BE MADE UNDER CONTRACT ITEM 960.620 SPECIAL PROVISION (REMOVE ELECTRIC POWER METER AND FLASHING BEACON).											
		A	W1-1R																														
		A	W13-1P																														
NB	1.102	A	W1-2R	30	30	FY	 9/14/17								1					14'-0" X				INSTALL SIGN 350' NORTH OF EXISTING SIGN AT MP 1.036 NB	X								
		A	W13-1P	18	18	FY																			X								
SIGN SUMMARY SHEET							SHEET TOTALS											PROJECT NAME: STATEWIDE-SOUTH REGION PROJECT NUMBER: STPG SIGN(57)															
							26.42	0.00	3	0	0	5	0	0	2	30.0	0	0.0	0.0	0.0	0.0	FILE NAME: z16t041Wallinaford103 NB.xls PLOT DATE: 2/27/2017											
							SF	SF	EA	EA	EA	EA	EA	EA	EA	EA	EA	EA	EA	EA	EA	EA	PROJECT MANAGER: D. MUNRO DRAWN BY: W. GORDON										
VERMONT AGENCY OF TRANSPORTATION							TOWN DIRECTIONAL TOTALS											DESIGNED BY: P. MCKECHNIE CHECKED: BRZEZOWSK															
							173.8	0.0	14	1	1	33	0	0	23	335.0	0		0.0			WALLINGFORD VT-103 NB 3 SHEET 112 OF 264											