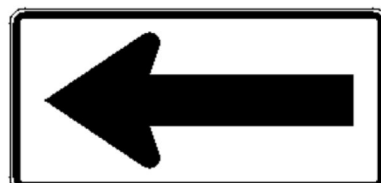


DIRECTION	MILEPOINT	LOCATION CODE (SHEET 4)	SIGN CODE	WIDTH (IN)	HEIGHT (IN)	SHEETING REMARKS	SIGN LEGEND	NEW SIGNS		EXISTING SIGNS				EXIST POST		NUMBER OF NEW POSTS	SQUARE STEEL (IN)			TUBULAR STEEL Ø (IN)				SIGN FRAME REQUIRED	REMARKS	SIGN DETAIL LOCATION								
								"A"	"B"	RETAIN	SALVAGE FROM	SALVAGE TO	REMOVE	RETAIN	REMOVE		1.75	2.00	2.50	FOUNDATION	3.00	3.50	4.00			5.00	SHSM	SIGN DETAILS SHEET #	STANDARD SHEET #					
																	(LB / FT)				(LB / FT)													
																	1.88	2.42	3.35		7.60	9.00	10.80			14.60								
NB WALLINGFORD VT RTE 103							FY-FLUORESCENT YELLOW FYG-FLUORESCENT YELLOW GREEN															"SHSM"-STANDARD HIGHWAY SIGNS AND MARKINGS BOOK												
NB	1.123	A	VD-701	6	10		BRIDGE 47 VT-103 9/14/17	0.42							1	7'-3" X							INSTALL ACROSS FROM EXISTING SIGN SOUTHBOUND			T-42								
NB	1.332	A	W1-2L				LEFT CURVE					1		X																				
		A	W13-1P				35 M.P.H. PLAQUE					1																						
NB	1.376	A	W1-2L	30	30	FY	9/13/17	6.25							1	14'-9" X							INSTALL ±230' NORTH OF EXISTING SIGN AT MP 1.332 NB	X										
		A	W13-1P	18	18	FY		2.25																X										
NB	1.406	A	W1-6				9/11/17					1	X											INSTALL ON RETAINED POSTS	X									
		A	W1-6	48	24	FY		8.00																										
NB	1.408	B	W1-6				9/11/17					1		X			12'-3" 12'-0" X							INSTALL ±10' NORTH OF EXISTING SIGN AT MP 1.406 NB	X									
		B	W1-6	48	24	FY		8.00							2																			
NB	1.434	B	W1-6	48	24	FY	9/11/17	8.00							2	12'-0" 11'-9" X								INSTALL ±50' SOUTH OF EXISTING SIGN AT MP 1.443 NB	X									
NB	1.441	A	W1-6				9/11/17					1		X			12'-3" 12'-0" X																	
		A	W1-6	48	24	FY		8.00							2								X											
NB	1.443	B	W1-6				LARGE ARROW BOARD RIGHT					1		X																				
NB	1.556	A	VW-092				9/11/17					1	X																					
		A	VW-092	30	30			6.25																INSTALL ON RETAINED POST			T-81							
SIGN SUMMARY SHEET							SHEET TOTALS		47.17	0.00	0	0	0	7	0	0	8	115.0	0	0.0	0.0	0.0	0.0	PROJECT NAME: STATEWIDE-SOUTH REGION										
									SF	SF	EA	EA	EA	EA	EA	EA	EA		FT		EA	LB	LB	LB	LB	PROJECT NUMBER: STPG SIGN(57)								
																										FILE NAME: z16t041Wallinaford103 NB.xls								
																										PLOT DATE: 2/27/2017								
VERMONT AGENCY OF TRANSPORTATION							TOWN DIRECTIONAL TOTALS		173.8	0.0	14	1	1	33	0	0	23	335.0	0	0.0				DRAWN BY: W. GORDON										
																										CHECKED BRZEZOWSKI								
																			DESIGNED BY: P. MCKECHNIE										WALLINGFORD VT-103 NB 4			SHEET 113 OF 264		