


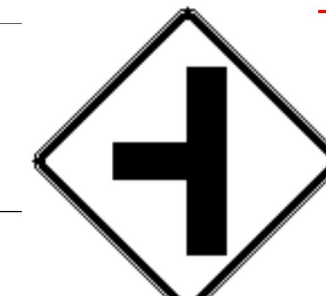






DIRECTION	MILEPOINT	LOCATION CODE (SHEET 4)	SIGN CODE	WIDTH (IN)	HEIGHT (IN)	SHEETING REMARKS	SIGN LEGEND	NEW SIGNS		EXISTING SIGNS				EXIST POST		NUMBER OF NEW POSTS	SQUARE STEEL (IN)			TUBULAR STEEL Ø (IN)				SIGN FRAME REQUIRED	REMARKS	SIGN DETAIL LOCATION			
								"A"	"B"	RETAIN	SALVAGE FROM	SALVAGE TO	REMOVE	RETAIN	REMOVE		1.75	2.00	2.50	FOUNDATION	3.00	3.50	4.00			5.00	SHSM	SIGN DETAILS SHEET #	STANDARD SHEET #
																	(LB / FT)				(LB / FT)								
SB WALLINGFORD VT RTE 103							FY-FLUORESCENT YELLOW FYG-FLUORESCENT YELLOW GREEN															"SHSM"-STANDARD HIGHWAY SIGNS AND MARKINGS BOOK							
SB	2.126	F	W1-2L	30	30		 9/12/17	6.25								1	14'-3" X								INSTALL ±410' DOWNSTATION FROM EXISTING SIGN AT MP 0.074 SB IN SHREWSBURY	X			
SB	2.057	F	W1-6	48	24		 9/12/17	8.00								2	12'-3" 12'-0" X								INSTALL ±165' UPSTATION FROM EXISTING SIGN AT MP 2.026 SB	X			
SB	2.026	F	W1-6				LARGE ARROW BOARD LEFT																				1	X	
SB	1.980	E	W1-6				 9/12/17	8.00																		INSTALL ON RETAINED POSTS	X		
SB	1.786	F	W2-2L																							1	X		
		F	W16-8P				 9/12/17																			1			
		F	W2-2L	30	30		 9/12/17	6.25																				X	
		F	W16-8P	36	8			2.00																				5	
SB	1.556	F	VW-092	30	30		 9/12/17	6.25								1	14'-0" X								INSTALL SIGN ACROSS FROM SAME SIGN LOCATED AT MP 1.556 NB.			T-81	
SB	1.472	F	W1-2R	30	30		 9/12/17	6.25								1	15'-3" X								INSTALL SIGN ±165' UPSTATION FROM EXISTING SIGN AT MP 1.441 NB.	X			
		F	W13-1P	18	18		 9/12/17	2.25																				X	
SB	1.311	F					FLASHING BEACON																		REMOVE FLASHING BEACON AND ELECTRIC POWER METER AFTER DISCONNECTING FROM THE POWER SOURCE. PAYMENT WILL BE MADE UNDER CONTRACT ITEM 960.620 SPECIAL PROVISION (REMOVE ELECTRIC POWER METER AND FLASHING BEACON).				
		F	W1-1L				LEFT TURN																			1			
		F	W13-1P				30 M.P.H. PLAQUE																				1		
SIGN SUMMARY SHEET							SHEET TOTALS	45.25	0.00	0	0	0	7	0	0	5	75.0	0	0.0	0.0	0.0	0.0	0.0	0.0	0.0	PROJECT NAME: STATEWIDE-SOUTH REGION PROJECT NUMBER: STPG SIGN(57)			
VERMONT AGENCY OF TRANSPORTATION							TOWN DIRECTIONAL TOTALS	163.5	0.0	7	0	0	40	0	0	21	305.0	0				0.0				FILE NAME: z16t041Wallinaford103 SB.xls PLOT DATE: 2/27/2017 PROJECT MANAGER: D. MUNRO DRAWN BY: W. GORDON DESIGNED BY: P. MCKECHNIE CHECKED: BRZEZOWSKA WALLINGFORD VT-103 SB 1 SHEET 116 OF 264			