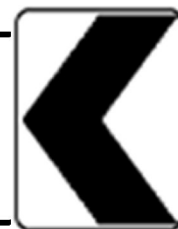
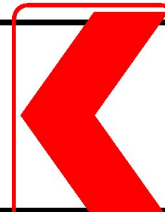
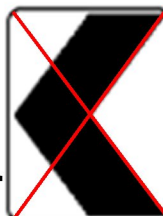
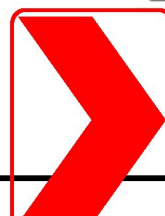


DIRECTION	MILEPOINT	LOCATION CODE (SHEET 4)	SIGN CODE	WIDTH (IN)	HEIGHT (IN)	SHEETING REMARKS	SIGN LEGEND	NEW SIGNS		EXISTING SIGNS				EXIST POST		NUMBER OF NEW POSTS	SQUARE STEEL (IN)			TUBULAR STEEL Ø (IN)				SIGN FRAME REQUIRED	REMARKS	SIGN DETAIL LOCATION			
								"A"	"B"	RETAIN	SALVAGE FROM	SALVAGE TO	REMOVE	RETAIN	REMOVE		1.75	2.00	2.50	FOUNDATION	3.00	3.50	4.00			5.00	SHSM	SIGN DETAILS SHEET #	STANDARD SHEET #
																	(LB / FT)				(LB / FT)								
																	1.88	2.42	3.35		7.60	9.00	10.80			14.60			
SB WALLINGFORD VT RTE 103							FY-FLUORESCENT YELLOW FYG-FLUORESCENT YELLOW GREEN															"SHSM"-STANDARD HIGHWAY SIGNS AND MARKINGS BOOK							
SB	1.164	E	W1-8L				RIGHT CHEVRON						1		X														
SB	1.161	G	R8-3	24	24		 9/13/17	4.00								1		12'-6" X								X			
SB	1.159	F	R8-3				NO PARKING SYMBOL SYMBOL						1		X														
SB	1.154	F	W1-8L				LEFT CHEVRON						1		X														
SB	1.154	E	W1-8R				RIGHT CHEVRON						1		X														
SB	1.153	F	W1-8L	18	24	FY	 9/13/17	3.00								1		12'-9" X								X			
SB	1.152	E	W1-8R	18	24	FY	 9/13/17	3.00								1		12'-0" X								X			
SB	1.146	G	R8-3	24	24		 9/13/17	4.00								1		12'-6" X								X			
SB	1.144	F	W1-8L				LEFT CHEVRON						1		X														
SB	1.144	E	W1-8R				RIGHT CHEVRON						1		X														
SB	1.139	F	R8-3				NO PARKING SYMBOL SYMBOL						1		X														
SB	1.138	E	W1-8R	18	24	FY	  9/13/17	3.00								1		12'-9" X								X		SIGNS SWAPPED PER TSMO DIRECTION	
SB	1.137	F	W1-8L	18	24	FY	  9/13/17	3.00								1		12'-9" X								X		SIGNS SWAPPED PER TSMO DIRECTION	
SB	1.134	F	W1-8L				LEFT CHEVRON						1		X														
SB	1.123	F	W1-8L	18	24	FY	 9/13/17	3.00								1		12'-9" X								X			
SIGN SUMMARY SHEET							SHEET TOTALS	23.00	0.00	0	0	0	8	0	0	6		90.0		0	0.0	0.0	0.0	0.0	PROJECT NAME: STATEWIDE-SOUTH REGION	PLOT DATE: 2/27/2017			
								SF	SF	EA	EA	EA	EA	EA	EA	EA		FT		EA	LB	LB	LB	LB					
							TOWN DIRECTIONAL TOTALS							163.5	0.0	7	0	0	40	0	0	21		305.0					0
VERMONT AGENCY OF TRANSPORTATION																								FILE NAME: z16t041Wallinaford103 SB.xls	PROJECT MANAGER: D. MUNRO	DRAWN BY: W. GORDON			
																								DESIGNED BY: P. MCKECHNIE	CHECKED: BRZEWOWSKI	SHEET 118 OF 264			
																								WALLINGFORD VT-103 SB 3					