
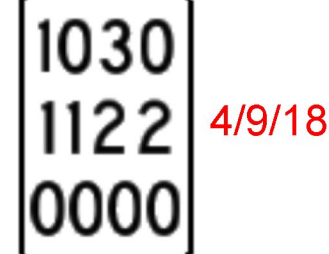
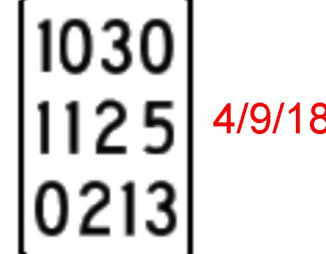






DIRECTION	MILEPOINT	LOCATION CODE (SHEET 4)	SIGN CODE	WIDTH (IN)	HEIGHT (IN)	SHEETING REMARKS	SIGN LEGEND	NEW SIGNS		EXISTING SIGNS			EXIST POST		NUMBER OF NEW POSTS	SQUARE STEEL (IN)			TUBULAR STEEL Ø (IN)				SIGN FRAME REQUIRED	REMARKS	SIGN DETAIL LOCATION				
								"A"	"B"	RETAIN	SALVAGE FROM	SALVAGE TO	REMOVE	RETAIN		REMOVE	1.75	2.00	2.50	FOUNDATION	3.00	3.50			4.00	5.00	SHSM	SIGN DETAILS SHEET #	STANDARD SHEET #
																	(LB / FT)				(LB / FT)								
NB SHREWSBURY VT ROUTE 103							FY-FLUORESCENT YELLOW FYG-FLUORESCENT YELLOW GREEN															"SHSM"-STANDARD HIGHWAY SIGNS AND MARKINGS BOOK							
							NOTE: DIVISION IS 0.05 +/- MILES DIFFERENT AT THE TOWN LINE																						
NB	0.000	C	VD-700				MILE MARKER 1030 / 1122 / 0000																INSTALL THIS ASSEMBLY CENTERED IN THE SAME POSITION AS THE EXISTING						
		C	VD-024	72	10		 10/27/17	5.00															TOWN LINE POST LOCATED AT MP 0.000 SB			T-94			
		C	VD-700	6	10		 4/9/18	0.42															INSTALL SHREWSBURY MILE MARKER ON THE LEFT POST UNDER SHREWSBURY			T-44			
		C	VD-700	6	10		 4/9/18	0.42															INSTALL WALLINGFORD MILE MARKER ON THE RIGHT POST UNDER WALLINGFORD			T-44			
NB	0.038	A	R2-5a				REDUCE SPEED AHEAD																						
		A	W3-5	36	36		 10/13/17	9.00																X					
NB	0.079	A	VD-018A				 9/15/17																						
		A	VD-018A	36	24		Jct U.S. 7 6	6.00															INSTALL ON RETAINED POST			T-95			
NB	0.110	A	R2-1				 9/15/17																						
		A	R2-1	30	36			7.50															INSTALL ON RETAINED POST	X					
NB	0.214	A	VW-060				HIDDEN DRIVES																						
		A	VW-060	30	30		 7/12/18	6.25															INSTALL SIGN ±200' NORTH OF EXISTING SIGN AT MP 0.214 NB			T-81			
NB	0.456	A	W11-2				PEDESTRIAN TRAFFIC																						
SIGN SUMMARY SHEET							SHEET TOTALS	34.58	0.00	0	0	0	6	0	0	5	75.0	0	0.0	0.0	0.0	0.0	PROJECT NAME: STATEWIDE-SOUTH REGION PROJECT NUMBER: STPG SIGN(57)						
VERMONT AGENCY OF TRANSPORTATION							TOWN DIRECTIONAL TOTALS	190.2	0.0	12	1	1	35	0	0	20	290.0	0		0.0			FILE NAME: z16t041Shrewsbury103NB.xls PLOT DATE: 2/27/2017 PROJECT MANAGER: D. MUNRO DRAWN BY: W. GORDON DESIGNED BY: P. MCKECHNIE CHECKED: BRZEZOWSKI SHREWSBURY VT-103 NB 1 SHEET 122 OF 264						