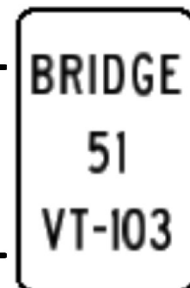


DIRECTION	MILEPOINT	LOCATION CODE (SHEET 4)	SIGN CODE	WIDTH (IN)	HEIGHT (IN)	SHEETING REMARKS	SIGN LEGEND	NEW SIGNS		EXISTING SIGNS				EXIST POST		NUMBER OF NEW POSTS	SQUARE STEEL (IN)			TUBULAR STEEL Ø (IN)				SIGN FRAME REQUIRED	REMARKS	SIGN DETAIL LOCATION																																																																																																																																																																																																																																																																																																																																																																																																																																																																																																																																																																																																					
								"A"	"B"	RETAIN	SALVAGE FROM	SALVAGE TO	REMOVE	RETAIN	REMOVE		1.75	2.00	2.50	FOUNDATION	3.00	3.50	4.00			5.00	SHSM	SIGN DETAILS SHEET #	STANDARD SHEET #																																																																																																																																																																																																																																																																																																																																																																																																																																																																																																																																																																																																		
																	(LB / FT)				(LB / FT)																																																																																																																																																																																																																																																																																																																																																																																																																																																																																																																																																																																																										
																	1.88	2.42	3.35		7.60	9.00	10.80			14.60																																																																																																																																																																																																																																																																																																																																																																																																																																																																																																																																																																																																					
SB SHREWSBURY VT ROUTE 103							FY-FLUORESCENT YELLOW FYG-FLUORESCENT YELLOW GREEN															"SHSM"-STANDARD HIGHWAY SIGNS AND MARKINGS BOOK																																																																																																																																																																																																																																																																																																																																																																																																																																																																																																																																																																																																									
SB	2.356	F	VW-376							1			+	X									SIGN RETAINED																																																																																																																																																																																																																																																																																																																																																																																																																																																																																																																																																																																																								
		F	VW-376	30	30			6.25															INSTALL ON RETAINED POST		2																																																																																																																																																																																																																																																																																																																																																																																																																																																																																																																																																																																																						
SB	2.319	F	R15-1				RAILROAD CROSS BUCK			1				X																																																																																																																																																																																																																																																																																																																																																																																																																																																																																																																																																																																																																	
SB	2.168	E	W10-1				 9/14/17						1		X																																																																																																																																																																																																																																																																																																																																																																																																																																																																																																																																																																																																																
		E	W10-1	36	36			7.07							1	14'-6" X							36" DIAMETER	X																																																																																																																																																																																																																																																																																																																																																																																																																																																																																																																																																																																																							
SB	1.897	F	VD-062B				 9/15/17	OFFICIAL BUSINESS DIRECTIONAL SIGN							X									SPRING LAKE RANCH																																																																																																																																																																																																																																																																																																																																																																																																																																																																																																																																																																																																							
SB	1.682	F	W1-4R	30	30			6.25							1	14'-0" X							INSTALL SIGN 200' NORTH OF EXISTING SIGN AT MP 1.644 SB	X																																																																																																																																																																																																																																																																																																																																																																																																																																																																																																																																																																																																							
SB	1.644	F	S3-1				 12/1/17						1		X																																																																																																																																																																																																																																																																																																																																																																																																																																																																																																																																																																																																																
		F	S3-1	36	36	FYG		9.00							2	15'-3" 14'-9" X							SCHOOL BUS STOP AT SPRING LAKE RD	X																																																																																																																																																																																																																																																																																																																																																																																																																																																																																																																																																																																																							
SB	1.604	F	W1-10L					HORIZONTAL ALIGNMENT									1																																																																																																																																																																																																																																																																																																																																																																																																																																																																																																																																																																																																														
		F	W13-1P					40 MPH																																																																																																																																																																																																																																																																																																																																																																																																																																																																																																																																																																																																																							
		F	VD-701					BRIDGE / 51 / VT 103																																																																																																																																																																																																																																																																																																																																																																																																																																																																																																																																																																																																																							
SB	1.602	F	VD-701	6	10		 10/12/17									1	7'-6" X										T-42																																																																																																																																																																																																																																																																																																																																																																																																																																																																																																																																																																																																				
SIGN SUMMARY SHEET							SHEET TOTALS										28.99	0.00	2	0	0	6	0	1	5	70.0	0	0.0	0.0	0.0	0.0	PROJECT NAME: STATEWIDE-SOUTH REGION																																																																																																																																																																																																																																																																																																																																																																																																																																																																																																																																																																																															
																	SF	SF	EA	EA	EA	EA	EA	EA	EA	EA	EA	EA	EA	EA	EA	EA	PROJECT NUMBER: STPG SIGN(57)																																																																																																																																																																																																																																																																																																																																																																																																																																																																																																																																																																																														
																																FILE NAME: z16t041Shrewsburv103SB.xls	PLOT DATE: 2/27/2017																																																																																																																																																																																																																																																																																																																																																																																																																																																																																																																																																																																														
							VERMONT AGENCY OF TRANSPORTATION																									DESIGNED BY: P. MCKECHNIE	CHECKED: W. GORDON																																																																																																																																																																																																																																																																																																																																																																																																																																																																																																																																																																																														
							TOWN DIRECTIONAL TOTALS										220.6	0.0	7	1	1	37	0	1	26	380.0	0	0.0				SHREWSBURY VT-103 SB 3																																																																																																																																																																																																																																																																																																																																																																																																																																																																																																																																																																																															
																																																																																																																																																																																																																																																																																																																																																																																																																																																																																																																																																																																																																															</