

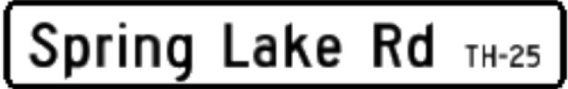






DIRECTION	MILEPOINT	LOCATION CODE (SHEET 4)	SIGN CODE	WIDTH (IN)	HEIGHT (IN)	SHEETING REMARKS	SIGN LEGEND	NEW SIGNS		EXISTING SIGNS			EXIST POST		NUMBER OF NEW POSTS	SQUARE STEEL (IN)			TUBULAR STEEL Ø (IN)				SIGN FRAME REQUIRED	REMARKS	SIGN DETAIL LOCATION				
								"A"	"B"	RETAIN	SALVAGE FROM	SALVAGE TO	REMOVE	RETAIN		REMOVE	1.75	2.00	2.50	FOUNDATION	3.00	3.50			4.00	5.00	SHSM	SIGN DETAILS SHEET #	STANDARD SHEET #
																	(LB / FT)				(LB / FT)								
SB SHREWSBURY VT ROUTE 103							FY-FLUORESCENT YELLOW FYG-FLUORESCENT YELLOW GREEN															"SHSM"-STANDARD HIGHWAY SIGNS AND MARKINGS BOOK							
SB	1.512	G	VR-017				 9/15/17					1	X										INSTALL ON RETAINED POST			T-70			
		G	VR-017	24	30																								
SB	1.502	FE	D3-1				SPRING LAKE RD TH-25					1		X															
		H	R1-1				STOP					1																	
		G	VD-700				MILE MARKER 1030 / 1122 / 0154			1		1																	
		H	R1-1	30	30		 9/15/17								1								X						
		G	VD-700				MILE MARKER 1030 / 1122 / 0154					1											INSTALL BACK TO BACK ON STOP SIGN POST						
SB	1.502	FE	D3-1	68	12		 12/1/17								2											7			
SB	1.148	F	R2-5A				 9/15/17					1		X															
		F	W3-5	36	36										2								X						
SB	1.080	F	VD-018A	36	24		 10/12/17								1											T-95			
SB	1.024	F	R2-1				 10/13/17					1		X															
		F	R2-1	30	36										1								X						
SB	0.841	F	R2-1				 9/15/17					1		X															
		F	R2-1	30	36																		X						
SIGN SUMMARY SHEET							SHEET TOTALS	46.92	0.00	0	1	1	7	0	0	7	105.0	0	0.0	0.0	0.0	0.0	PROJECT NAME: STATEWIDE-SOUTH REGION PROJECT NUMBER: STPG SIGN(57)						
VERMONT AGENCY OF TRANSPORTATION							TOWN DIRECTIONAL TOTALS	220.6	0.0	7	1	1	37	0	1	26	380.0	0		0.0			FILE NAME: z16t041Shrewsbury103SB.xls PLOT DATE: 2/27/2017 PROJECT MANAGER: D. MUNRO DRAWN BY: W. GORDON DESIGNED BY: P. MCKECHNIE CHECKED: BRZEZOWSKA SHREWSBURY VT-103 SB 4 SHEET 131 OF 264						