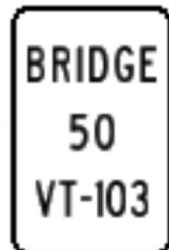


DIRECTION	MILEPOINT	LOCATION CODE (SHEET 4)	SIGN CODE	WIDTH (IN)	HEIGHT (IN)	SHEETING REMARKS	SIGN LEGEND	NEW SIGNS		EXISTING SIGNS				EXIST POST		NUMBER OF NEW POSTS	SQUARE STEEL (IN)			TUBULAR STEEL Ø (IN)				SIGN FRAME REQUIRED	REMARKS	SIGN DETAIL LOCATION			
								"A"	"B"	RETAIN	SALVAGE FROM	SALVAGE TO	REMOVE	RETAIN	REMOVE		1.75	2.00	2.50	FOUNDATION	3.00	3.50	4.00			5.00	SHSM	SIGN DETAILS SHEET #	STANDARD SHEET #
																	(LB / FT)				(LB / FT)								
																	1.88	2.42	3.35		7.60	9.00	10.80			14.60			
SB SHREWSBURY VT ROUTE 103							FY-FLUORESCENT YELLOW FYG-FLUORESCENT YELLOW GREEN															"SHSM"-STANDARD HIGHWAY SIGNS AND MARKINGS BOOK							
SB	0.648	F	VW-133R					10/13/17					1	X															
		F	VW-133R	30	30				6.25																INSTALL ON RETAINED POST			T-81	
SB	0.638	F	VD-701					11/28/17					1	X															
		F	VD-701	6	10				0.42																INSTALL ON RETAINED POST			T-42	
SB	0.505	F	R2-1					10/13/17					1	X															
		F	R2-1	24	30				5.00																INSTALL ON RETAINED POST	X			
SB	0.434	F	VW-060					10/13/17					1		X														
		F	VW-060	30	30				6.25						1		14'-9" X										T-81		
SB	0.119	F	R2-1					10/13/17					1	X															
		F	R2-1	24	30				5.00																INSTALL ON RETAINED POST	X			
SB	0.074	F	W1-2L					LEFT CURVE					1		X														
SIGN SUMMARY SHEET							SHEET TOTALS		22.92	0.00	0	0	0	6	0	0	1	15.0	0	0.0	0.0	0.0	0.0	PROJECT NAME: STATEWIDE-SOUTH REGION					
								SF	SF	EA	EA	EA	EA	EA	EA	EA		FT	EA	LB	LB	LB	LB	PROJECT NUMBER: STPG SIGN(57)					
																								FILE NAME: z16t041Shrewsburv103SB.xls					
																									PLOT DATE: 2/27/2017				
VERMONT AGENCY OF TRANSPORTATION							TOWN DIRECTIONAL TOTALS		220.6	0.0	7	1	1	37	0	1	26	380.0	0	0.0				DRAWN BY: W. GORDON					
																								CHECKED BRZEZOWSKI					
																						SHREWSBURY VT-103 SB 6							
																						SHEET 133 OF 264							