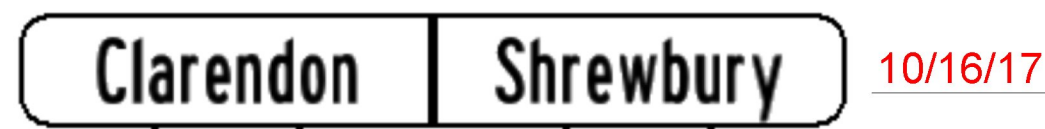
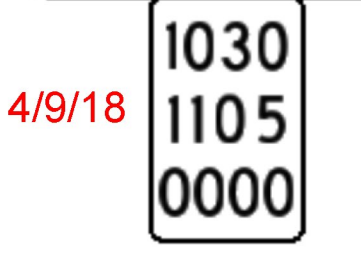
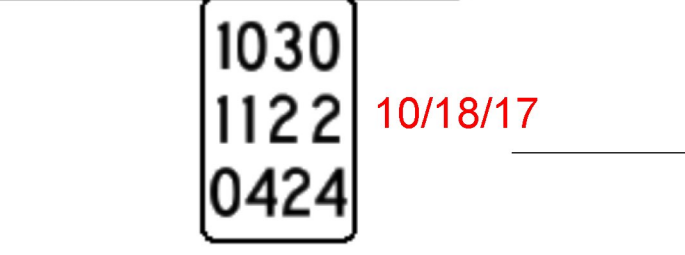

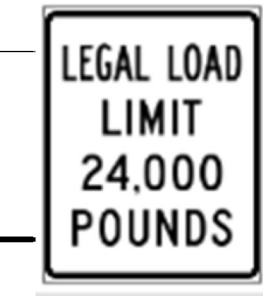


DIRECTION	MILEPOINT	LOCATION CODE (SHEET 4)	SIGN CODE	WIDTH (IN)	HEIGHT (IN)	SHEETING REMARKS	SIGN LEGEND	NEW SIGNS		EXISTING SIGNS			EXIST POST		NUMBER OF NEW POSTS	SQUARE STEEL (IN)			TUBULAR STEEL Ø (IN)				SIGN FRAME REQUIRED	REMARKS	SIGN DETAIL LOCATION				
								"A"	"B"	RETAIN	SALVAGE FROM	SALVAGE TO	REMOVE	RETAIN		REMOVE	1.75	2.00	2.50	FOUNDATION	3.00	3.50			4.00	5.00	SHSM	SIGN DETAILS SHEET #	STANDARD SHEET #
																	(LB / FT)				(LB / FT)								
NB CLARENDON VT ROUTE 103							FY-FLUORESCENT YELLOW FYG-FLUORESCENT YELLOW GREEN															"SHSM"-STANDARD HIGHWAY SIGNS AND MARKINGS BOOK							
NB	0.000	C	VD-024				CLARENDON SHREWSBURY																						
		C	VD-700				MILE MARKER 1030 / 1122 / 0424																						
		C	VD-700				MILE MARKER 1030 / 1105 / 0000															INSTALL THIS ASSEMBLY CENTERED IN THE SAME POSITION AS THE EXISTING							
		C	VD-024	72	10			5.00														TOWN LINE POST LOCATED AT MP 4.234 NB			T-94				
		C	VD-700	6	10			0.42														INSTALL CLARENDON MILE MARKER ON THE LEFT POST UNDER CLARENDON			T-44				
		C	VD-700	6	10			0.42														INSTALL SHREWSBURY MILE MARKER ON THE RIGHT POST UNDER SHREWSBURY			T-44				
NB	0.023	A	W2-7L				 10/16/17															OFFSET SIDEROADS							
NB	0.040	A		30	30			6.25														INSTALL 250' UPSTATION FROM EXISTING SIGN AT MP 0.023 NB		2					
NB	0.128	A	D4-2L				PARK - RIDE ←←			1																			
NB	0.163	AB	D3-1				RAILROAD DR																						
		C	W10-1				RAILROAD CROSSING				1		1																
NB	0.163	C	VR-017				LLL 24,000 LBS																						
		C	W14-1				DEAD END					1		1															
		C	VR-017	24	30		 10/13/17	5.00														INSTALL ON RETAINED POST			T-70				
SIGN SUMMARY SHEET							SHEET TOTALS	17.08	0.00	1	2	0	8	0	0	3	45.0	0	0.0	0.0	0.0	0.0	PROJECT NAME: STATEWIDE-SOUTH REGION PROJECT NUMBER: STPG SIGN(57)						
VERMONT AGENCY OF TRANSPORTATION							TOWN DIRECTIONAL TOTALS	182.0	0.0	16	2	2	53	0	0	14	200.0	0		0.0			FILE NAME: z16t041Clarendon103 NB.xls PROJECT MANAGER: D. MUNRO DESIGNED BY: P. MCKECHNIE CLARENDON VT-103 NB 1	PLOT DATE: 2/27/2017 DRAWN BY: W. GORDON CHECKED: BRZEZOWSK SHEET 134 OF 264					